


Woodson Co. Kas.

Sec. 7 - 24 - 14E

Farm. *Estes* No. 2
Theta Oil Company

Elev. T. D.

Log No. 8905

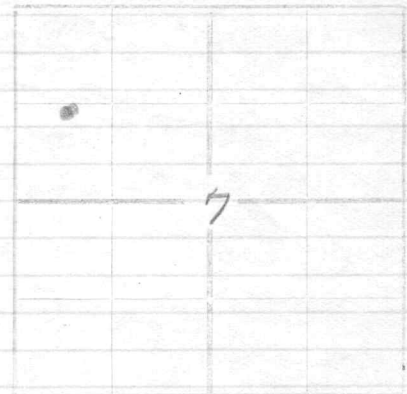

- soil-2
- sd-5
- li-10
- sh-50
- li-60
- sh-65
- li-75
- sh-130
- li-180
- sh-200
- li-210
- sh-235
- li-275
- sh-340
- li-350
- sh-510
- li-780
- sh-785
- R.P.-800
- sh-820
- li-900
- sh-905
- li-960
- sh-1120
- li-1130
- sh-1140
- li-1150
- sh-1170
- sd-1190-2 B.W.
- li-1240
- sh-1260
- li-1300
- sh-1520
- sd-1575 H.F.W.
- sh-1625
- sh-1640
- li-1672
- sd-1679

Drilling Commenced: 10-20-21
Drilling Completed: 11-21-21

10"	785'	Pulled
8 1/4"	1180'	"
6 5/8"	1640'	Left in