

Woodson


Form 51-5M-2-29-34703

Map No. KANSAS Sec. 7 Twp. 24 R. 14

Well No. 2 - Estes Farm

Theta Oil Company

NORTH

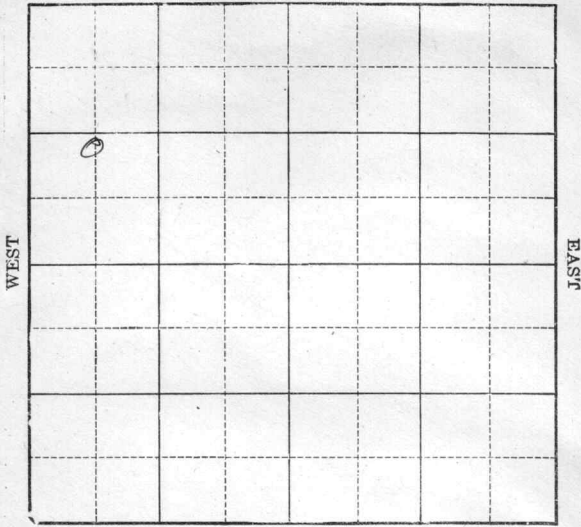

SOUTH

Location _____
Drilling Remarks _____

Rig Up _____
Drilling Remarks _____

RECORD

PRODUCTION

Cased _____ in. _____ ft.
Sand _____
Gas _____
Oil _____
Total Depth _____

1st 24 hrs. Nat. _____
1st 24 hrs. after shot _____
Gas _____ cu. ft. _____
Dry Hole _____
Abandoned _____

Woodson

MAP No. Kns SEC 7 TWP. 24 R. 14

WELL No. 2 Tester
Theta Oil Co COMPANY

CONTRACTOR

FIRST REPORTS
COMPLETED

SECTION PLAT

o			

_____ FT. FROM N. LINE
 _____ FT. FROM S. LINE
 _____ FT. FROM E. LINE
 _____ FT. FROM W. LINE

RECORD

LOCATION _____

RIG UP _____

DRILLING AND REMARKS:

20 Bls.

CASED _____ IN. _____ FT.

SAND 1672-1679

GAS _____

OIL _____

TOTAL DEPTH 1679'

PRODUCTION

1ST 24 HRS. NAT. _____

1ST 24 HRS. AFTER SHOT _____

GAS _____ CU. FT.

DRY HOLE _____

ABANDONED _____

DATE

11/29/21 192

Sherwood, SCOUT