

Woodson


Form 51-5M-2-29-34703

Map No. KANSAS Sec. 7 Twp. 24 R. 14

Well No. 3 - Estes Farm

Shita Oil Company

NORTH

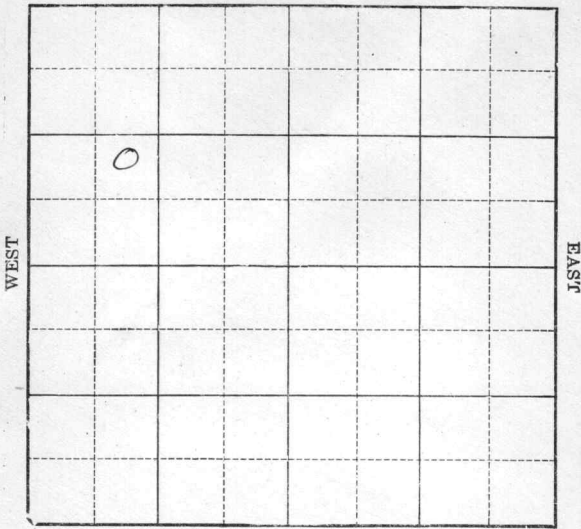

SOUTH

Location \_\_\_\_\_

Drilling Remarks \_\_\_\_\_

Rig Up \_\_\_\_\_

Drilling Remarks \_\_\_\_\_

RECORD

Cased \_\_\_\_\_ in. \_\_\_\_\_ ft.

Sand \_\_\_\_\_

Gas \_\_\_\_\_

Oil \_\_\_\_\_

Total Depth \_\_\_\_\_

PRODUCTION

1st 24 hrs. Nat. \_\_\_\_\_

1st 24 hrs. after shot \_\_\_\_\_

Gas \_\_\_\_\_ cu. ft.

Dry Hole \_\_\_\_\_

Abandoned \_\_\_\_\_

*Woodson*

MAP NO. *Kns 8* SEC. *7* TWP. *24* R. *14*

WELL NO. *3* *Ester*  
*Theta Oil Co.* COMPANY

CONTRACTOR

FIRST REPORTS  
 COMPLETED

SECTION PLAT

\_\_\_\_\_ FT. FROM N. LINE  
 \_\_\_\_\_ FT. FROM S. LINE  
 \_\_\_\_\_ FT. FROM E. LINE  
 \_\_\_\_\_ FT. FROM W. LINE

o			

RECORD

LOCATION \_\_\_\_\_

CASED \_\_\_\_\_ IN. \_\_\_\_\_ FT.

RIG UP \_\_\_\_\_

SAND *1707-1716*

DRILLING AND REMARKS:

GAS \_\_\_\_\_

*10 Bls.*

OIL \_\_\_\_\_

TOTAL DEPTH *1716*

PRODUCTION

1ST 24 HRS. NAT. \_\_\_\_\_

1ST 24 HRS. AFTER SHOT \_\_\_\_\_

GAS \_\_\_\_\_ CU. FT.

DRY HOLE \_\_\_\_\_

ABANDONED \_\_\_\_\_

DATE

*1/31/22* 192

*Sherwood*

SCOUT