

KANSAS

Form 51-5M-7-40-Palace

Barton


Section 8 Township 17 Range 11-W

Well No. I Radenberg

Company Republic Nat. Gas

NORTH

Kraft Pool

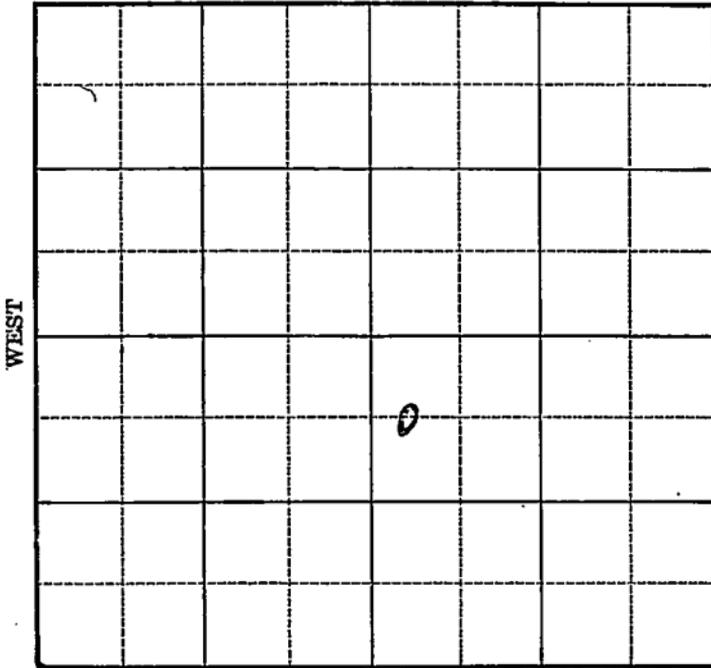

10

SOUTH

Sec. 8 Twp. 17 R. 11-W

Well No. #1 Radenberg Farm

Republic Natural Gas Company

(Kraft)


660 Ft. from N. Line

_____ Ft. from S. Line

_____ Ft. from E. Line

330 Ft. from W. Line

Elev. 1870

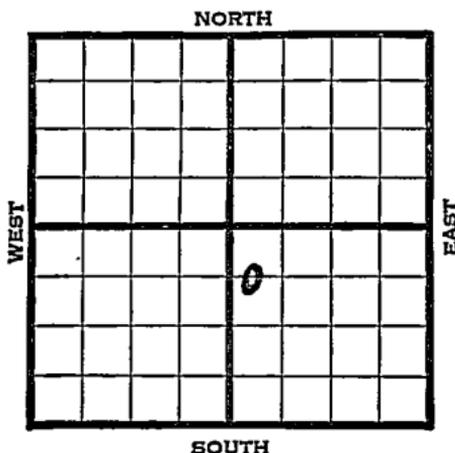

1941	REPORT
2/19	8" - 240' WOC.
2/27	Drlg. 2698'
3/6	Topeka 2700' Lans. 3064'
	Arb. 3318-31' T.D. Run csg.
3/13	5" - 3321' T.D. 3332' 40' oil
	in 4 hours.
3/20	1750 acid.
3/26	Arb. 3318'
	5" - 3321'
	T.D. 3332'
	1670 acid.
	Potential 68 bbls., pump.
	39.5 Gravity
	COMPLETED

Map No. _____ Sec. 8 Twp. 17 R. 11WWell No. 1 Radenberg

_____ Republic Nat. Gas _____ Company

~~FIRST REPORT~~ _____ Contractor

• C W L N W S E

660 Ft. from N. Line


_____ Ft. from S. Line

_____ Ft. from E. Line

330 Ft. from W. Line

KRAFT POOL

SECTION PLAT

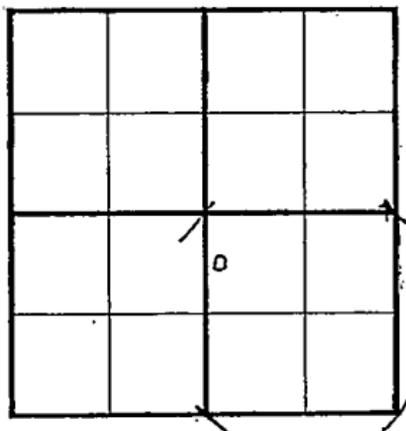

Location _____

Rig up _____

Drilling and Remarks:

8" - 240

WOC

RECORD

Cased _____ in., _____ ft.

Sand _____

Gas _____

Oil _____

Total Depth _____

PRODUCTION

1st 24 hrs. Nat. _____

1st 24 hrs. after shot _____

Gas _____ Cu. Ft.

Dry Hole _____

Abandoned _____

Date

FEB 19 1941 19S. J. LEWIS Scout

Map No. 55 Sec. 8 Twp. 17 R. 11WWell No. 1 RadenbergRepublic Natural Gas Company

Contractor

COMPLETED**SECTION PLAT**

C W L NW SE

660 Ft. from N. Line Ft. from S. Line Ft. from E. Line330 Ft. from W. Line

		0	

KRAFT POOL

Location _____

Rig up _____

Drilling and Remarks:

*Cor 83318.**5" @ 3321.**1670 acid**Pump 68 Pot.**395 Gr.***RECORD**

Cased _____ in., _____ ft.

Sand _____

Gas _____

Oil _____

Total Depth 3332**PRODUCTION**

1st 24 hrs. Nat. _____

1st 24 hrs. after shot _____

Gas _____ Cu. Ft.

Dry Hole _____

Abandoned _____

Date

MAR 26 1941 19

S. J. LEWIS Scout