


Barton

Section 9 Township 17 Range 11-W

Company Magnolia

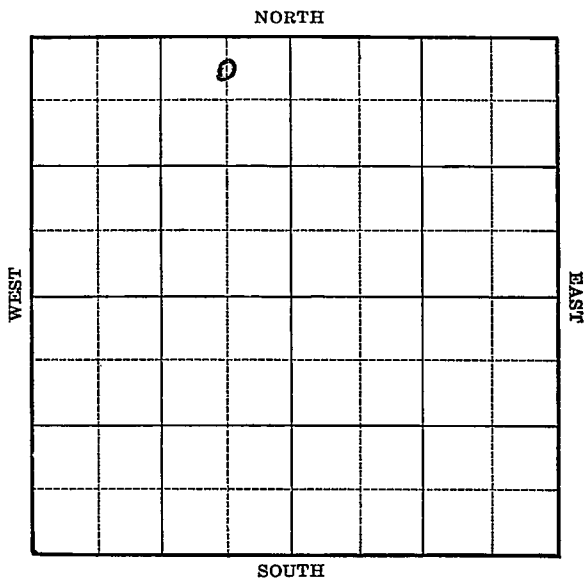

Sec. 9 Twp. 17 R. 11-WWell No. #1 Grossardt "A" FarmMagnolia Company

(Kraft)


330 Ft. from N. Line

Ft. from S. Line

660 Ft. from E. Line

Ft. from W. Line

Elev. 1853

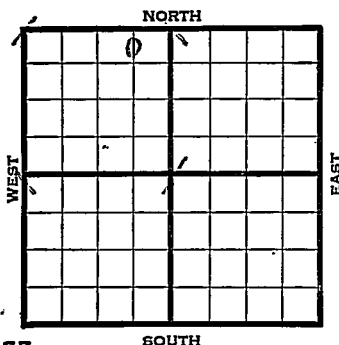

1941

## REPORT

2/12

10" - 258' WOC.

2/20

Drlg. 2200'

2/27

Lans. 3017' Arb. 3286'

5" - 3287' TD 3288' RUST.

3/6

T.D. 3293' Swab 15 bbls. per  
hour off bottom.

3/12

Arb. 3172'

6" - 3173'

T.D. 3192'

Echometer potential 3032 bbls.

Maximum 3000 bbls.

40.1 Gravity


COMPLETED

Map No. 55 Sec. 9 Twp. 17 R. 11WWell No. 1 Grossardt "A"Magnolia Company**FIRST REPORT** Contractor

C N L NE NW

330 Ft. from N. Line       Ft. from S. Line660 Ft. from E. Line       Ft. from W. Line

## SECTION PLAT

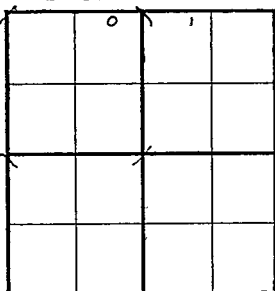

KRAFT POOL

Location                                 Rig up                                 

Drilling and Remarks:

10" - 258 WOC

## RECORD

Cased            in.,            ft.Sand                                 Gas                                 Oil                                 Total Depth                                 

## PRODUCTION

1st 24 hrs.-Nat.                                 1st 24 hrs. after shot                                 Gas                                  Cu. Ft.Dry Hole                                 Abandoned                                 

Date

FEB 12 1941 19S. J. LEWIS Scout

Map No. 53 Sec. 9 Twp. 17 R. 11WWell No. 1 Grossardt "A"Magnolia

Company

Contractor

**COMPLETED****SECTION PLAT**

C N L NE NW

330 Ft. from N. Line       Ft. from S. Line660 Ft. from E. Line       Ft. from W. Line

|  |   |  |  |
|--|---|--|--|
|  | 0 |  |  |
|  |   |  |  |
|  |   |  |  |
|  | X |  |  |

KRAFT POOL

Location                     Rig up                     

Drilling and Remarks:


Date

MAR 12 1941 19S. J. LEWIS Scout