

Section 8

Township 17

KANSAS
Range 11W

Well No. #2 Radenberg


Company Ogden Bros.

NORTH

9

WEST

EAST

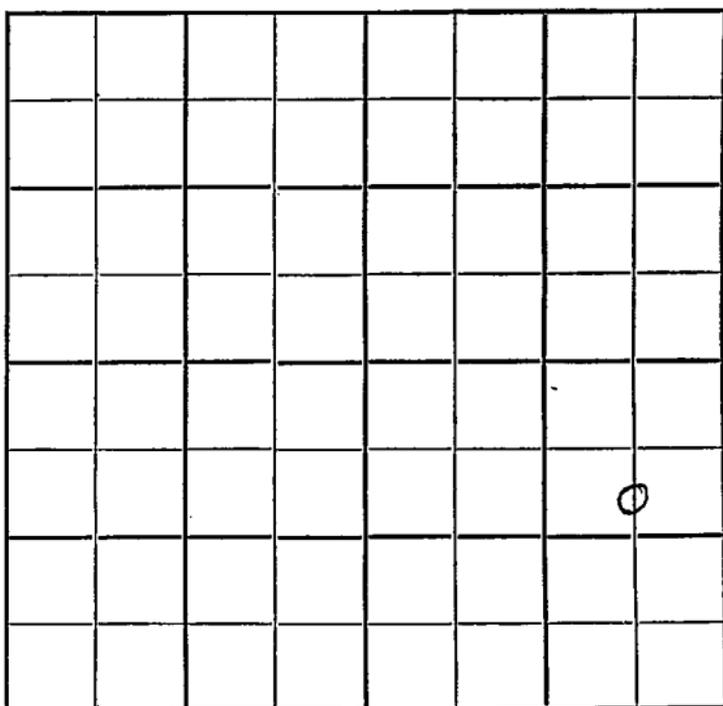

SOUTH

Barton

KANSAS

Sec. 8 Twp. 17 R. 11W

Well No. #2 Radenberg Farm

Ogden Bros. Company

Murfin Drlg. - Contr. Contractor

Kraft-Prusa Pool


990' Ft. from N. Line

_____ Ft. from S. Line

660' Ft. from E. Line

_____ Ft. from W. Line

C S L N E SE

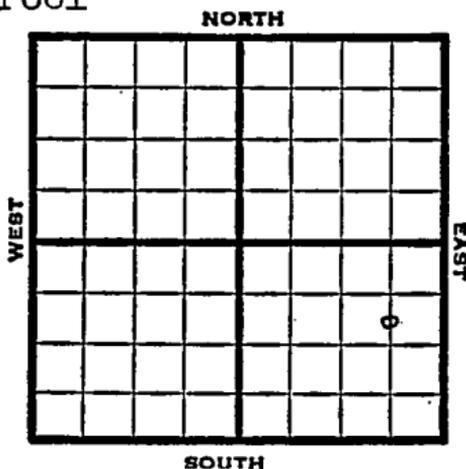

1950 Elev. 1854' REPORT

12/13 Location

1951
4/4

Spud 12-18-50

Oil well TD 3315' Arb. 3305-08'

5" @ 3306' TD 3315' 1750 A

S/ 2 1/2 BOPH

Comp. 45 BOPD

COMPLETED

