


Section 8 Township 17 Range 11-W

Well No. #2 Radenberg

Company Republic Natural

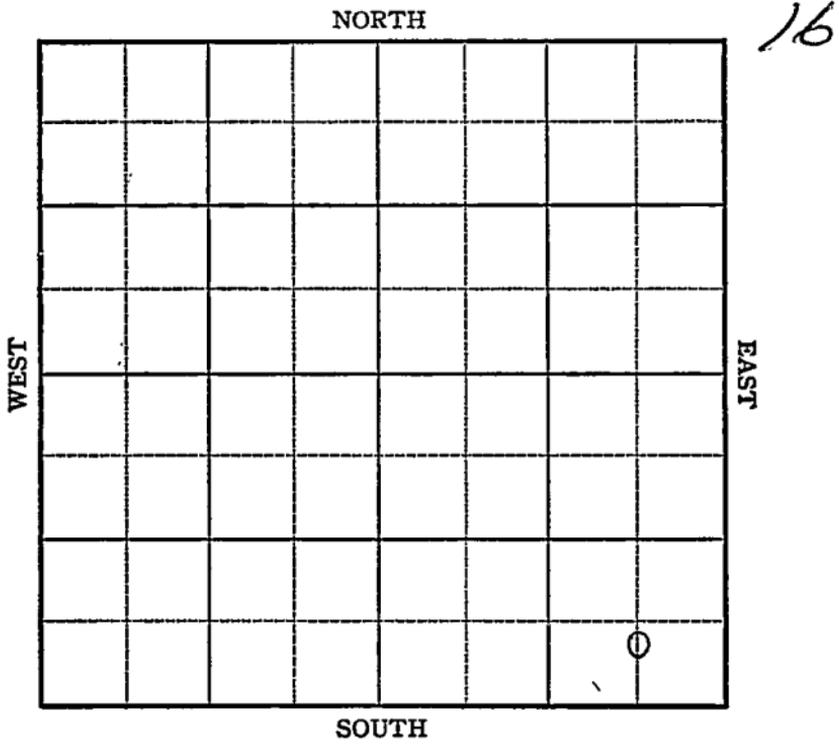

Sec. 8 Twp. 17 R. 11-W

Well No. #2 Radenberg Farm


Republic Natural Company

\_\_\_\_\_ Ft. from N. Line

475 Ft. from S. Line

660 Ft. from E. Line

\_\_\_\_\_ Ft. from W. Line

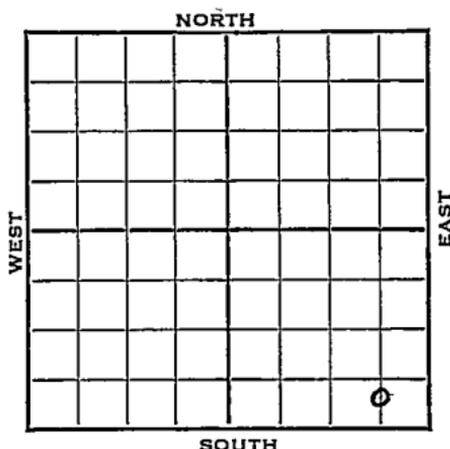

*Elev. 1855*

1943

REPORT

3/3 Drlg. 2000'

3/10 10" Casing set 238  
2500 SD

3/16 " "

3/24 Lans 3011  
Drlg. 3195'

3/31 Arb 3301 TD 3308 7" @ 3301 500 acid  
swab 15 oil per hr.

4/7 " " "

4/14 " " "

4/21 " " "

4/28 " " "

5/5 " " "

5/12 " " "

5/19 Pump 8 bbls oil per hr 60 hrs.

5/26 " " " " " "

6/2 " " " " " "

6/9 " " "

**OVER**

1943  
6/16

Arb. 3301  
7" @ 3301'  
T.D. 3308'  
2000 gal acid  
Pump 73 pot.  
Gravity 43.6

**COMPLETED**

**KANSAS**

Map No. 55 Sec. 8 Twp. 17 R. 11W

Well No. 2 Rad enberg

Republic Natural Company

FIRST REPORT Contractor

C SE SE

\_\_\_\_\_ Ft. from N. Line

475 Ft. from S. Line

660 Ft. from E. Line

\_\_\_\_\_ Ft. from W. Line

**SECTION PLAT**

			o

**KRAFT PRUSA POOL**

Location \_\_\_\_\_

Rig up \_\_\_\_\_

Drilling and Remarks:

Drlg. 2000'

**RECORD**

Cased \_\_\_\_\_ in., \_\_\_\_\_ ft.

Sand \_\_\_\_\_

Gas \_\_\_\_\_

Oil \_\_\_\_\_

Total Depth \_\_\_\_\_

**PRODUCTION**

1st 24 hrs. Nat. \_\_\_\_\_

1st 24 hrs. after shot \_\_\_\_\_

Gas \_\_\_\_\_ Cu. Ft.

Dry Hole \_\_\_\_\_

Abandoned \_\_\_\_\_

Date

MAR 3 1943 19

S. J. LEWIS Scout

Barton

KANSAS

Map No. 35 Sec. 8 Twp. 17 R. 11WWell No. 2 Radenberg

Republic Natural Company

COMPLETED Contractor

C S E S E

SECTION PLAT

\_\_\_\_\_ Ft. from N. Line

475 Ft. from S. Line660 Ft. from E. Line

\_\_\_\_\_ Ft. from W. Line

			0

KRAFT PRUSA POOL

Location \_\_\_\_\_

Rig up \_\_\_\_\_

Drilling and Remarks:

*Car #3301**5" @ 3301**2000 acid**Pump 730 ft.**436/34*

RECORD

Cased \_\_\_\_\_ in., \_\_\_\_\_ ft.

Sand \_\_\_\_\_

Gas \_\_\_\_\_

Oil \_\_\_\_\_

Total Depth 330 ft.

PRODUCTION

1st 24 hrs. Nat. \_\_\_\_\_

1st 24 hrs. after shot \_\_\_\_\_

Gas \_\_\_\_\_ Cu. Ft.

Dry Hole \_\_\_\_\_

Abandoned \_\_\_\_\_

Date

JUN 16 1943 19

S. J. LEWIS Scout