


Section 9 Township 17 Range 11 W

Well No. # 1 Disque

Company Brunson et al

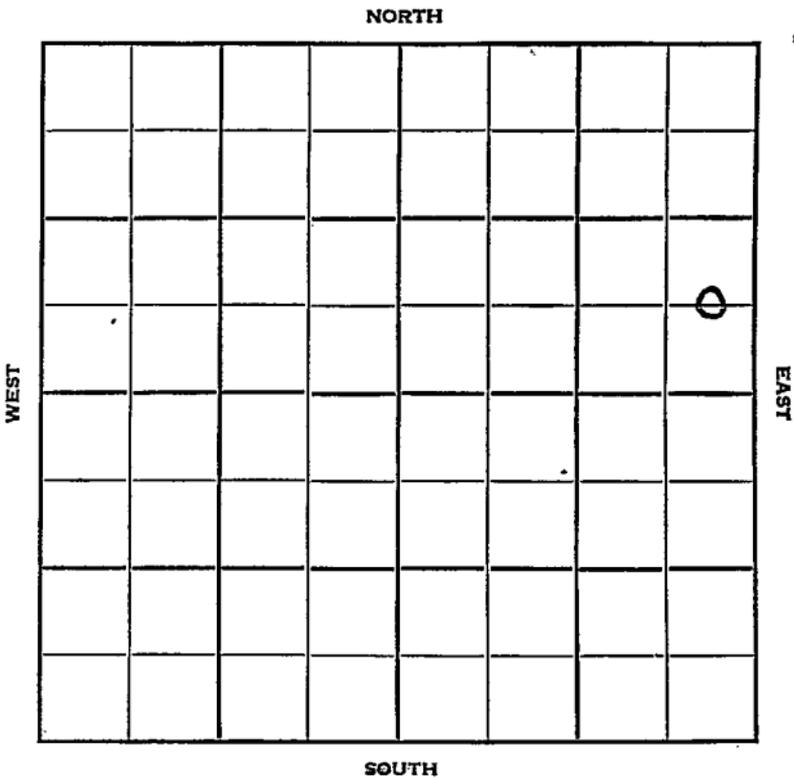

Sec. 9 Twp. 17 R. 11 W

Well No. #1 Disque Farm

Brunson et al Company

Brunson Contractor


\_\_\_\_\_ Ft. from N. Line

660 \_\_\_\_\_ Ft. from S. Line

330 \_\_\_\_\_ Ft. from E. Line

\_\_\_\_\_ Ft. from W. Line

C E/2 SE NE

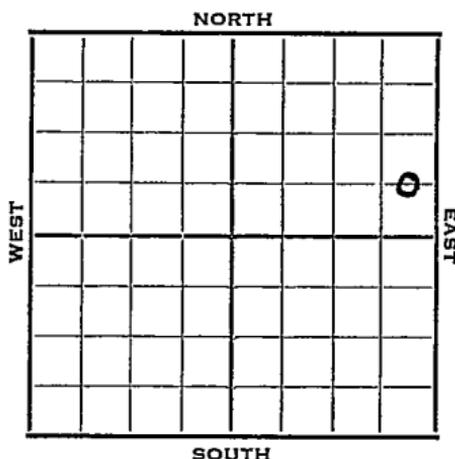

1952 Elev. 1853' REPORT

3/26	Spud 3-24-52 8" @ 290 Anhy 725' Drilling
4/1	Heeb. 2900 Tor. 2916 Br Li 3001 Lans. 3017 Drig. 3190'
4/8	Arb 3287-90 RTD 5" @ 3287 DP CO to 3290 SD 24/3287-90 opn hōle 42 mud A VSSO DD to 3307 B/10 bal oph 500 A Test 1/2 BOPH DD to 3307 S/3 BOPH fill up 750' oil 4. hrs.
4/23	500 A S/9 BOPH 2500' off btm. POP
4/30	NR
5/7	NR
5/14	"
5/21	"
5/28	"
6/11	"
6/18	NR
6/25	Spud 3-24-52 Oil Well TD 3307' 8" @ 290 Anhy 725 Heeb. 2900 Tor. 2916 Br Li 3001 Lans. 3017 Arb. 3287

OVER

1952

6/25 TD 3290 5" @ 3287 CO to 3290  
24/ 3287-90 42 A VSSO DD 3301  
B/ 10 goph 500 A  $\frac{1}{2}$  boph DD 3307  
S/ 3 boph FU 750' oil 4 hr.  
500 A S/ 9 boph  
Comp. 227 bopd

**COMPLETED**

County **Barton** State **Kansas**

Sec. **9** (Blk. Twp.) **17** (Sur. Rge.) **11W** Map No.

Operator **Brunson et al.**

Well No. **1** Farm **Disque**

Elev. Location **C E/2 SE NE**


**660** Ft. From **S** Line **NE**  
**330** Ft. From **E** Line Quarter

1st. Report . **MAR 26 1952**

Completion

Remarks

**-Brunson - Contr.**

Spudding Date **3-24-52**

Drlg. Data

**8" @ 290 Anhy 725 Drlg.**

J. G. McGEHEE

