

MUSAS

Trego

Section 24 Township 12 Range 21W


Well No. 1 Hamborg "B" - Hamborg 2-A

Company Sterling Drlg. 1165/DNL

NORTH

WEST

EAST

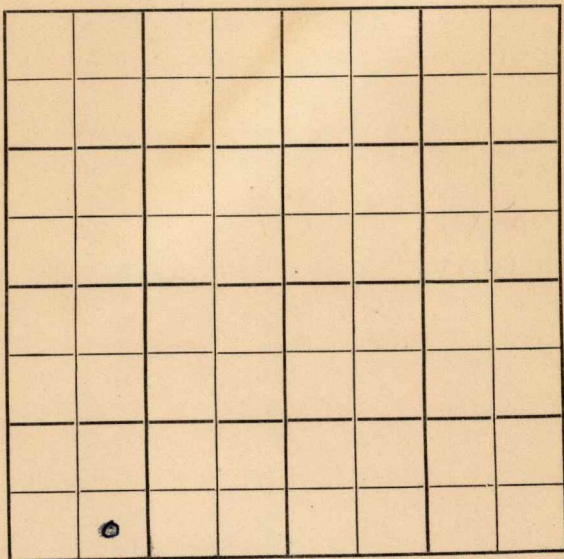

SOUTH

Trego **KANSAS**

Sec. 24 Twp. 12 R. 21 W

Well No. # 1 Hamborg "B" 2-A Farm

*1/65/DML*

Sterling Drlg. Company

Sterling Drlg. Contractor

Ridgeway Pool


Ft. from N. Line

330 Ft. from S. Line

Ft. from E. Line

990 Ft. from W. Line

SE SW SW

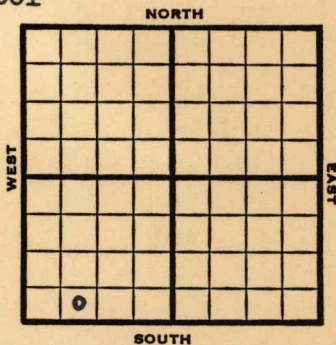

1952

**Elev. 2283'** REPORT

12/17

Spud 12-15-52  
8" @ 154 WOC

12/25 " " " "

1953

1/7

Spud 12-15-52 D & A TD 3985'  
8" @ 154 **KC 3568'** **Marm. 3873'**  
**B. Penn 3933'**

DST ~~3951~~-56 open 3/4 hr. rec 6' SW  
60# **Arb. 3962'** TD 3985'

D & A

**'ABANDONED**



