Barton KANSAS

SECTION 9 TOWNSHIP 17 RANGE 11W

WELL NO. #2 Kroutwurst

COMPANY Birmingham-Bartlett

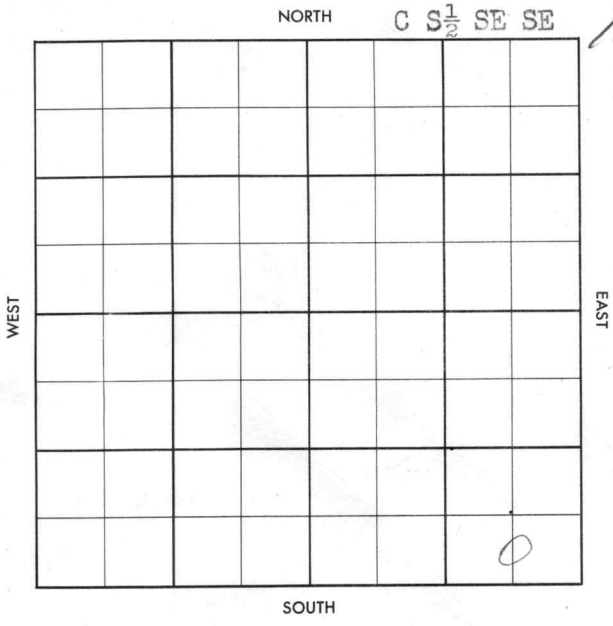

FORM 504-3 SUNRAY

FORM 513 SUNRAY

County Barton Elev. 1829

Sec. 9 Twp. 17 Rge. 11W

Company Birmingham-Bartlett

Farm Name Kroutwurst No. 2

TOPS	DEPTH	LOG	DATUM
Anh.	680		
Tp.			
H.	2876		
Tr.			
Dg.			
B.L.	2977		
L.	2993		
K.C.			
B.K.C.			
Ce.			
C.	3260		
M.			
M.			
K.			
Mz.			
Mq.			
V.			
S.			
S.			
A	3286		
R.			
P€.			
G.			
T.D.	3290		

Loc. in Sec. C S½ SE SE

Geol.

Contr.

Pool Kraft-Prusa

FIRST REPORT

JAN 30 '57

Date Comm. 1-20-57 Gulf - FO

8" @ 270 DST 3287-90 open 25 min.

rec. 180' gas 360' oil 1060/20"

5" @ 3287

13

Co. Lse. No. Sec. T. R.

FORM 513 SUNRAY

County Barton Elev. 1829

Sec. 9 Twp. 17 Rge. 11W

Company Birmingham-Bartlett

Farm Name Kroutwurst No. 2

TOPS	DEPTH	LOG	DATUM
Anh.	680		
Tp.			
H.	2876		
Tr.			
Dg.			
Bl.	2977		
L.	2993		
K.C.			
B.K.C.			
Ce.			
C.	3260		
M.			
M.			
K.			
Mz.			
Mg.			
V.			
S.			
S.			
A	3286		
R.			
P€.			
G.			
T.D.	3290		

Loc. in Sec. C S½ SE SE

Geol.

Contr.

Pool Kraft-Prusa

COMPLETE

FEB 6 '57

Date Comm. 1-20-57 Gulf - FO

8" @ 270 DST 3287-90 open 25 min.

rec. 180' gas 360' oil 1060/20"

5" @ 3287 FEB 6 '57 CO 3290 FO

1915' oil in 8 hrs BS 2½

Boph calc. & 9 Bopd n/s/w

PoP P. 100 Bopd n/s/w

Co. Lse. No. Sec. T. R.