

KANSAS


Barton

FORM 51 5M 4-41 PETROL

Section 9 Township 17 Range 11-W

Well No. #3 Diague

Company Skelly

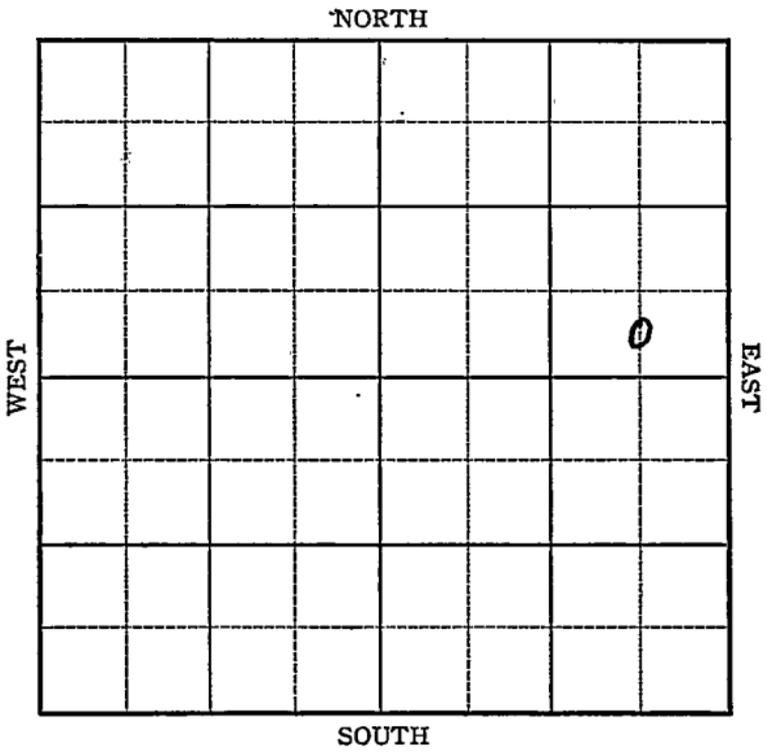

KANSAS

Barton

Sec. 9 Twp. 17 R. 11-W

Well No. #3 Disgue Farm

Skelly Company.

(Kraft)


_____ Ft. from N. Line

330 Ft. from S. Line

660 Ft. from E. Line

_____ Ft. from W. Line

Elev. 1846

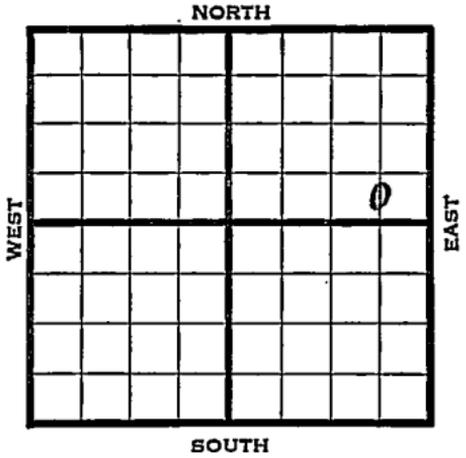

1941

REPORT

10/29 Derrick.

11/6 8" - 312' Drlg. 825'

11/13 Drlg. 2610'

11/19 Arb. 3347'

T.D. 3360'

Water.

ABANDONED

Barton

KANSAS

Map No. K-55 Sec. 9 Twp. 17 R. 11WWell No. 3 DisgueSkelly CompanyABANDONED Contractor

C S L S E N E

 Ft. from N. Line330 Ft. from S. Line660 Ft. from E. Line Ft. from W. Line

SECTION PLAT

			o

KRAFT POOL

RECORD

Location Cased in., ft.Rig up Sand

Drilling and Remarks:

Gas Oil Total Depth 2360 See 83347Water.

PRODUCTION

1st 24 hrs. Nat. 1st 24 hrs. after shot Gas Cu. Ft.Dry Hole Abandoned

Date

NOV 19 1941 19S. J. LEWIS Scout