

KANSAS

FORM 51 5M 4-41 PETROL

Barton


Section 9 Township 17 Range 11-W

Well No. #1 Kroutwurst

Company Gulf

NORTH Kraft pool

9

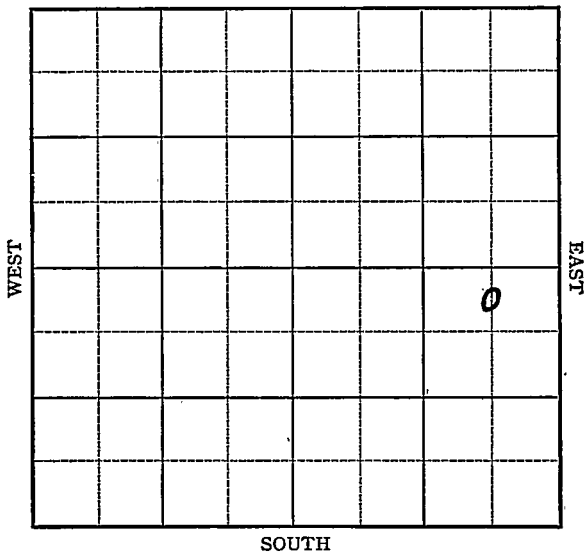

Sec. 9 Twp. 17 R. 11-W

Well No. #1 Kroutwurst Farm

Gulf Company

(Kraft)


330 Ft. from N. Line

Ft. from S. Line

660 Ft. from E. Line

Ft. from W. Line

Elev. 1836

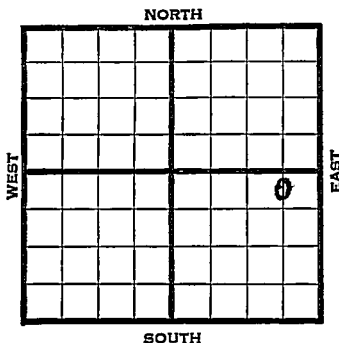

1941	REPORT
8/27	Drlg. 310' : 10" - 298' WOC.
9/4	Drlg. 2852'
9/11	Lans. 2995' Arb. 3261-64' T.D. 7" - 3262' RUST.
9/18	T.D. 3281' Swab 222 oil in 3 hours.
9/24	Arb. 3261' 7" - 3262' T.D. 3281'
	Sonic Potential 6362 bbls.
	Maximum 3000 bbls.
	45. Gravity
	COMPLETED

Map No. _____ Sec. 9 Twp. 17 R. 11W

Well No. 1 Kroutwurst

Gulf

Company

FIRST REPORT

Contractor

SECTION PLAT

C N L N E S E

330 Ft. from N. Line

_____ Ft. from S. Line

660 Ft. from E. Line

_____ Ft. from W. Line

			o

KRAFT POOL

Location _____

Rig up _____

Drilling and Remarks:

Drlg. 310

10" - 298 WOC

RECORD

Cased _____ in., _____ ft.

Sand _____

Gas _____

Oil _____

Total Depth _____

PRODUCTION

1st 24 hrs. Nat. _____

1st 24 hrs. after shot _____

Gas _____ Cu. Ft.

Dry Hole _____

Abandoned _____

Date

AUG 27 1941

19

S I LEWIS

Scout

Map No. K-55 Sec. 9 Twp. 17 R. 11W

Well No. 1 Kroutwurst

Gulf Company

COMPLETED

Contractor

SECTION PLAT

C NL NE SE

330 Ft. from N. Line

_____ Ft. from S. Line

660 Ft. from E. Line

_____ Ft. from W. Line

			o

KRAFT POOL

Location _____

Rig up _____

Drilling and Remarks:

Cor 3261

7" @ 3262

Sonic P 286362

Max 3000

45° Gr

RECORD

Cased _____ in., _____ ft.

Sand _____

Gas 1 _____

Oil _____

Total Depth 3281

PRODUCTION

1st 24 hrs. Nat. _____

1st 24 hrs. after shot _____

Gas _____ Cu. Ft.

Dry Hole _____

Abandoned _____

Date

SEP 24 1941 19

S. J. LEWIS Scout