


Section 9 Township 17 Range 11-W

Well No. #1 Krautwurst

Company Birmingham & Bartlett

Kraft-Prusa Pool  
NORTH

*16*

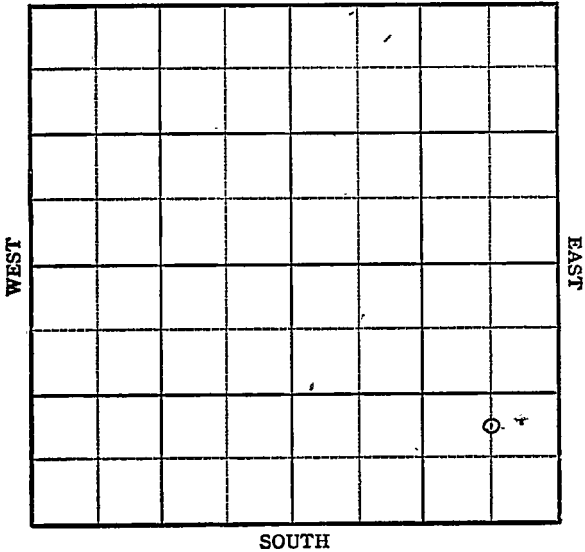

KANSAS

Barton.

Sec. 9

Twp. 17

R. 11W



Well No. #1 Krautwurst

Farm

Birmingham & Bartlett

Company

Kraft-Prusa Pool

\_\_\_\_\_ Ft. from N. Line

990'


\_\_\_\_\_ Ft. from S. Line

660'

\_\_\_\_\_ Ft. from E. Line

\_\_\_\_\_ Ft. from W. Line

C N L SE SE

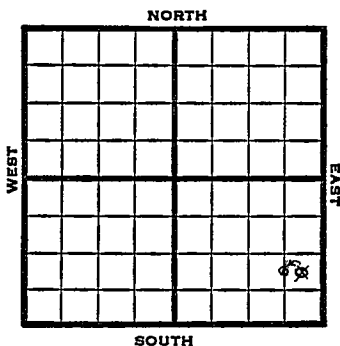

1948

Eli 1841'

REPORT

12/1

10" @ 250'

Lans. 3008'

Drlg. 3105'

12/8

TD 3317'

Arb 3301'

Aband.

**ABANDONED**

Kansas

Kraft-Prusa Pool

Map No. \_\_\_\_\_ Sec. 9 Twp. 17 R. 11WWell No. 1 Krautwurst

Birmingham &amp; Bartlett Company

## FIRST REPORT

Contractor

C N L SE SE

## SECTION PLAT


\_\_\_\_\_ Ft. from N. Line

990 Ft. from S. Line660 Ft. from E. Line

\_\_\_\_\_ Ft. from W. Line

Barton County

Location \_\_\_\_\_

Rig up \_\_\_\_\_

Drilling and Remarks: \_\_\_\_\_

10" @ 250

Lans. 3008

drlg. 3105

## RECORD

Cased \_\_\_\_\_ in., \_\_\_\_\_ ft.

Sand \_\_\_\_\_

Gas \_\_\_\_\_

Oil \_\_\_\_\_

Total Depth \_\_\_\_\_

## PRODUCTION

1st 24 hrs. Nat. \_\_\_\_\_

1st 24 hrs. after shot \_\_\_\_\_

Gas \_\_\_\_\_ Cu. Ft.

Dry Hole \_\_\_\_\_

Abandoned \_\_\_\_\_

Date

DEC 1 1948 19S. J. LEWIS Scout

