

KANSAS


FORM 51 5M 1-42 PETROL

Barton

Section 9 Township 17 Range 11-W

Well No. #2 Grossardt

Company Magnolia

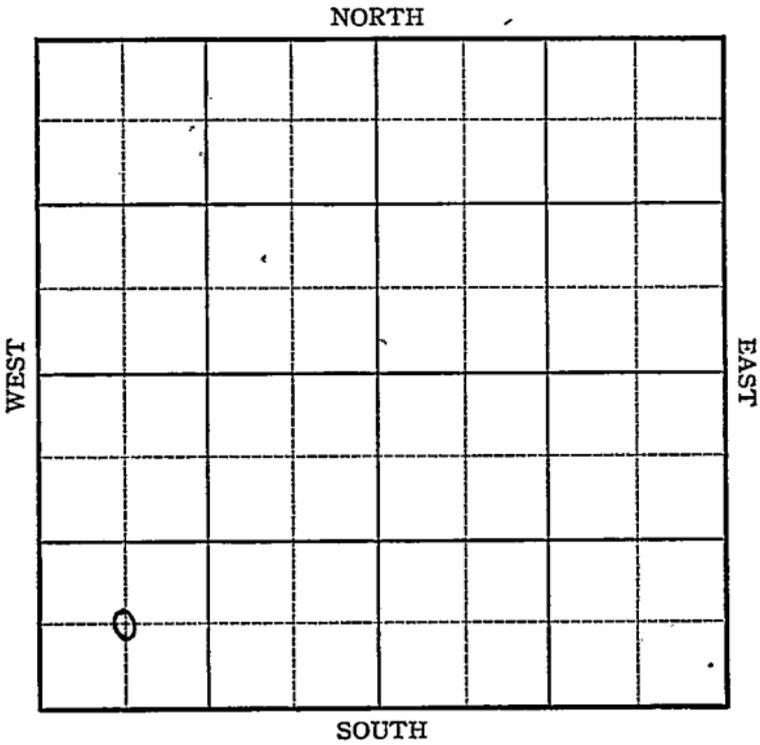

Sec. 9 Twp. 17 R. 11-W

Well No. #2 Grossardt Farm

Magnolia Company

Kraft Prusa Pool


_____ Ft. from N. Line

660 Ft. from S. Line

_____ Ft. from E. Line

660 Ft. from W. Line

Elev. 1842

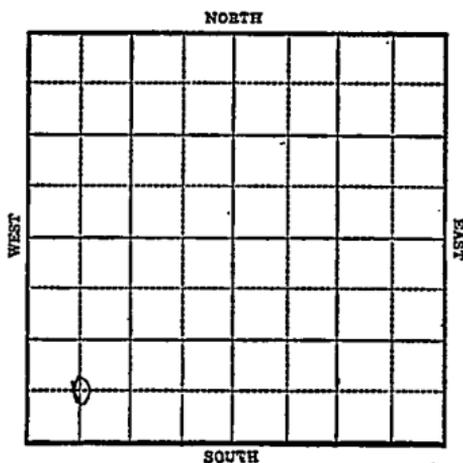

1943

R E P O R T

3/10	Location
3/16	Derrick.
3/24	10" @ 295' Drlg. 1370'
3/31	Drlg. 3260
4/7	Arb 3284 T.D. 3292 7" @ 3286-1150' in 11 hrs.
4/14	1000 acid pump 20 oil per hr 5 hrs.
4/21	Arb. 3284 7" @ 3286 T.D. 3292' 1000 gal. acid Echo Pot. 1745 Gravity 43.4

COMPLETED

Barton

KANSAS

Map No. 55 Sec. 9 Twp. 17 R. 11WWell No. 2 Grossardt

Magnolia

Company

FIRST REPORT

Contractor

C SW SW

SECTION PLAT

0			

_____ Ft. from N. Line

660

_____ Ft. from S. Line

_____ Ft. from E. Line

66.0

_____ Ft. from W. Line

KRAFT PRUSA POOL

Location XXX

Rig up _____

Drilling and Remarks:

RECORD

Cased _____ in., _____ ft.

Sand _____

Gas _____

Oil _____

Total Depth _____

PRODUCTION

1st 24 hrs. Nat. _____

1st 24 hrs. after shot _____

Gas _____ Cu. Ft.

Dry Hole _____

Abandoned _____

Date

MAR 1 0 1943 19

S. J. LEWIS

Scout

KANSAS

Barton

Map No. 55 Sec. 9 Twp. 17 R. 11WWell No. 2 GrossardtMagnolia CompanyCOMPLETED Contractor

C SW SW

 Ft. from N. Line660 Ft. from S. Line Ft. from E. Line660 Ft. from W. Line

SECTION PLAT

o	/		

KRAFT PRUSA POOL

Location Rig up

Drilling and Remarks:

*Cr. #3284**7" @ 3286**1000 acid**Ec in Pad #1745**43 1/2 hr*

RECORD

Cased in., ft.Sand Gas Oil Total Depth 3292

PRODUCTION

1st 24 hrs. Nat. 1st 24 hrs. after shot Gas Cu. Ft.Dry Hole Abandoned

Date

APR 21 1943 19S. J. LEWIS Scout