


Section 9 Township 17 Range 11-W

Well No. #5 Grossardt

Company Magnolia

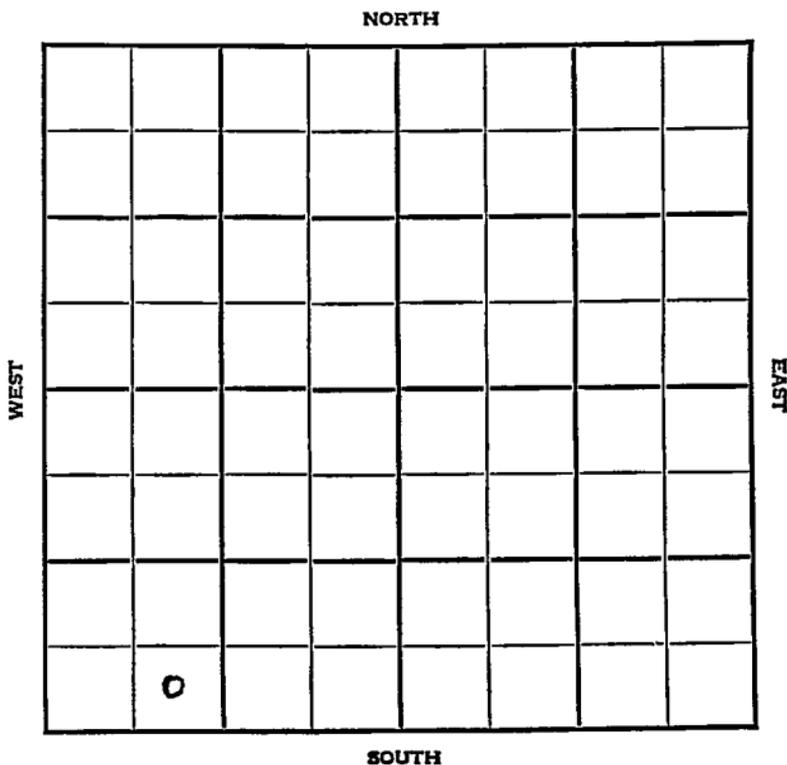

KANSAS

Barton



Sec. 9 Twp. 17 R. 11W

Well No. #5 Grossardt Farm

Magnolia Company

Kraft-Prusa

NORTH

Ft. from N. Line


330' Ft. from S. Line

Ft. from E. Line

990' Ft. from W. Line

WEST

EAST

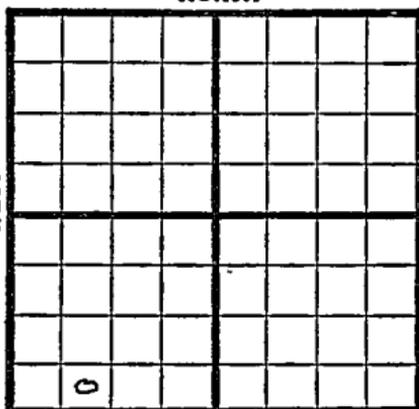

SOUTH

SE SW SW

1948

Elv. 1839' REPORT

5/5 Location

5/12 RUR

5/19 8" @ 305'
Drlg. 3132'

6/1 Arbuckle 3275'
5" @ 3276'
Depth Pot. 1056 oil
Gr. 42°
TD 3280'

COMPLETED

Map No. _____ Sec. 9 Twp. 17 R. 11W

Well No. 5 Grossardt

Magnolia Company

FIRST REPORT Contractor

SE SW SW

SECTION PLAT

_____ Ft. from N. Line

330 Ft. from S. Line

_____ Ft. from E. Line

990 Ft. from W. Line

Barton County

Location X

Rig up _____

Drilling and Remarks:

RECORD

Cased _____ in., _____ ft.

Sand _____

Gas _____

Oil _____

Total Depth _____

PRODUCTION

1st 24 hrs. Nat. _____

1st 24 hrs. after shot _____

Gas _____ Cu. Ft.

Dry Hole _____

Abandoned _____

Date

MAY 5 1948 19

S. J. LEWIS Scout

