


Section 9 Township 17 Range 11-~~W~~

Well No. #5 Grossardt "A"

Company Magnolia

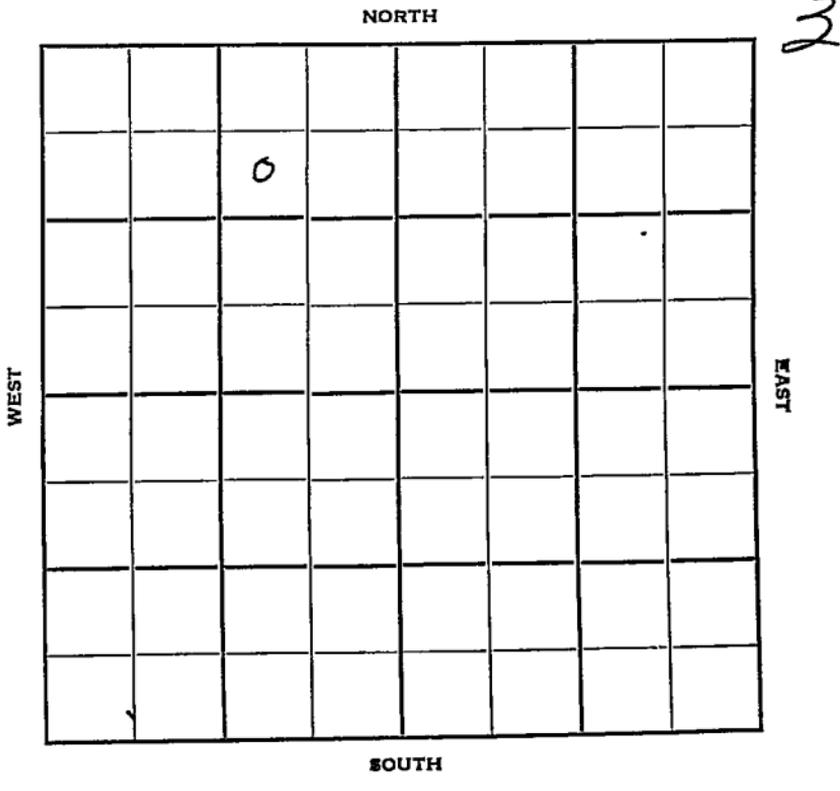

Barton KANSAS

Sec. 9 Twp. 17 R. 11W

Well No. #5 Grossardt "A" Farm

Magnolia Company

Mallonee Contr. Contractor

Kraft-Prusa Pool


990' Ft. from N. Line

\_\_\_\_\_ Ft. from S. Line

990' Ft. from E. Line

\_\_\_\_\_ Ft. from W. Line

SW NE NW

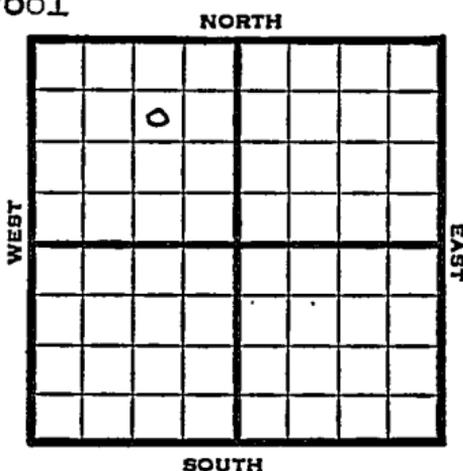

1950 Elev. 1857' REPORT

10/18 Spud 10-14-50  
10 @ 336'

11/15 Spud 10-14-50  
Oil Well TD 3298'  
10" @ 336'  
KC 3019' Arb. 3287-90 TD  
7" @ 3288' FU 300' oil DD 3292  
S/16 BOPH 7 hr. DD 3294  
500 A  
S/125 BO DD 3298 S/139 BO 3 hr.  
Comp. 2213 BOPD

COMPLETED

County Barton State Kansas

Sec. 9 (Blk. Twp.) 17 (Sur. Rge.) 11W Map No.

Operator Magnolia

Well No. 5 Farm Grossardt "A"

Elev. \_\_\_\_\_ Location SW NE NW

	0				
FIRST REPORT					

990 Ft. From N Line NW

990 Ft. From E Line Quarter

Ist. Report OCT 18 1950

Completion \_\_\_\_\_

Remarks \_\_\_\_\_

Mallonee - Contr.

Spudding Date 10-14-50

Drlg. Data Kraft-Prusa Pool

10" @ 336

County Barton State Kansas

Sec. 9 (Blk. 17) (Sur. 11W) (Twp. 17) (Rge. 11W) Map No.

Operator Magnolia

Well No. 5 Farm Grossardt "A"

Elev. 1857 Location SW NE NW

	0				
<b>COMPLETE</b>					

990 Ft. From N Line NW

990 Ft. From E Line Quarter

1st. Report

Completion NOV 15 1950

Remarks Kraft-Prusa Pool

Mallonee - Contr.

Spudding Date 10-14-50

Drlg. Data Oil well TD 3298

10" @ 336 KC 3019 Arb. 3287-90 TD

7" @ 3288 FU 300' oil. DD 3292

S/ 16 boph 7 hr. DD 3294 500 A

S/ 125 bo DD 3298 S/ 139 bo 3 hr.

Comp. 2213 bopd

J. E. TYRA