

KANSAS


FORM 51 5M 1-42 PETROL

Barton

Section 9 Township 17 Range 11-~~17~~

Well No. #4 Grossardt "A"

Company Magnolia

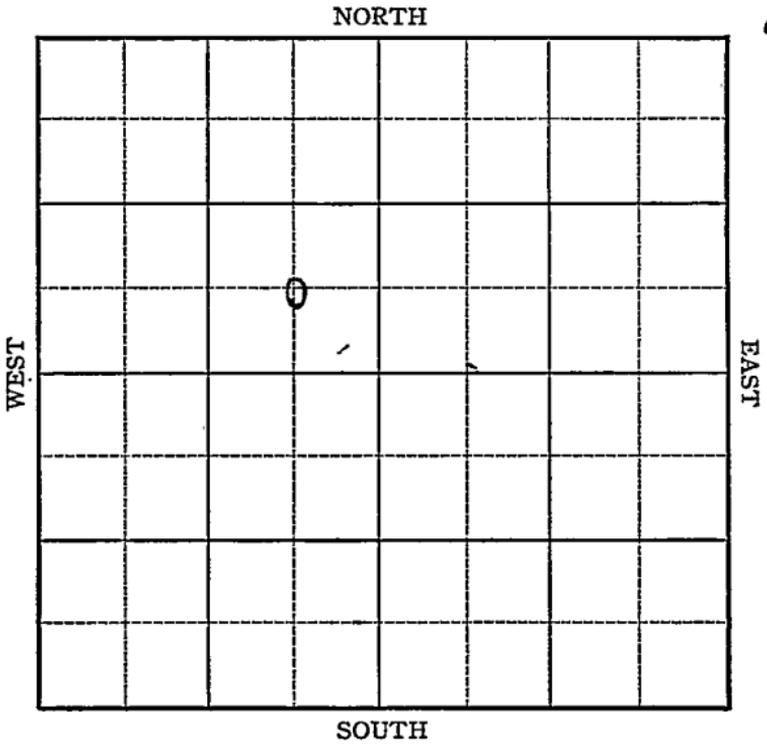

KANSAS

Barton

Sec. 9 Twp. 17 R. 11-W

Well No. #4 Grossardt "A" Farm

Magnolia Company


Kraft Prusa

 Ft. from N. Line

660 Ft. from S. Line

660 Ft. from E. Line

 Ft. from W. Line

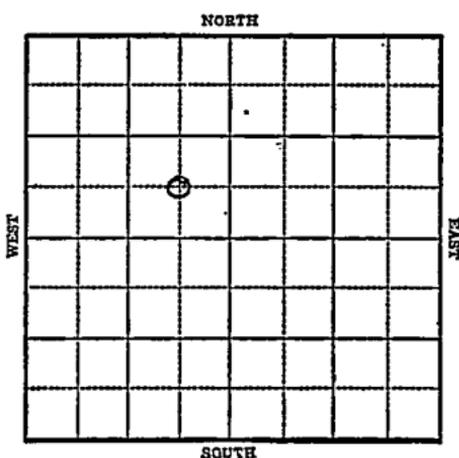

Elev. 1852

R E P O R T

1943

6/30

Location.

7/7

10" @ 235'
Drig. 1650'

7/15

Arb 3294-96 T.D.
6" @ 3296
RUST

7/21

T.D. 3315-500 acid
Pump 60 oil in 12 hrs.

7/28

Arb. 3294
6" @ 3296
T.D. 3315'
500 acid
Pump 184 Pot.
Gravity 42.8

COMPLETED

KANSAS

Map No. 55 Sec. 9 Twp. 17 R. 11W

Well No. 4 Grossardt "A"

Magnolia Company

FIRST REPORT Contractor

C S E NW

SECTION PLAT

_____ Ft. from N. Line

660 Ft. from S. Line

660 Ft. from E. Line

_____ Ft. from W. Line

	o		

KRAFT PRUSA POOL

Location XXX

Rig up _____

Drilling and Remarks:

RECORD.

Cased _____ in., _____ ft.

Sand _____

Gas _____

Oil _____

Total Depth _____

PRODUCTION

1st 24 hrs. Nat. _____

1st 24 hrs. after shot _____

Gas _____ Cu. Ft.

Dry Hole _____

Abandoned _____

Date

JUN 3 0 1943 19

S. J. LEWIS Scout

Barton

Map No. 55 Sec. 9 Twp. 17 R. 11W

Well No. 4 Grossardt "A"

Magnolia

Company

COMPLETED

Contractor

C SE NW

SECTION PLAT

	o		

Ft. from N. Line

660 Ft. from S. Line

660 Ft. from E. Line

Ft. from W. Line

KRAFT PRUSA POOL

Location _____

Rig up _____

Drilling and Remarks:

CR 3294

6" @ 3296

500 acil

Pump 184 P.Y.

42 E.M.

RECORD

Cased _____ in., _____ ft.

Sand _____

Gas _____

Oil _____

Total Depth 3295

PRODUCTION

1st 24 hrs. Nat. _____

1st 24 hrs. after shot _____

Gas _____ Cu. Ft.

Dry Hole _____

Abandoned _____

Date

JUL 28 1943 19

S. J. LEWIS Scout