


KANSAS

BARTON

Section 10 Township 17 Range 11W

Well Number 1 Kraft

Company Price et al

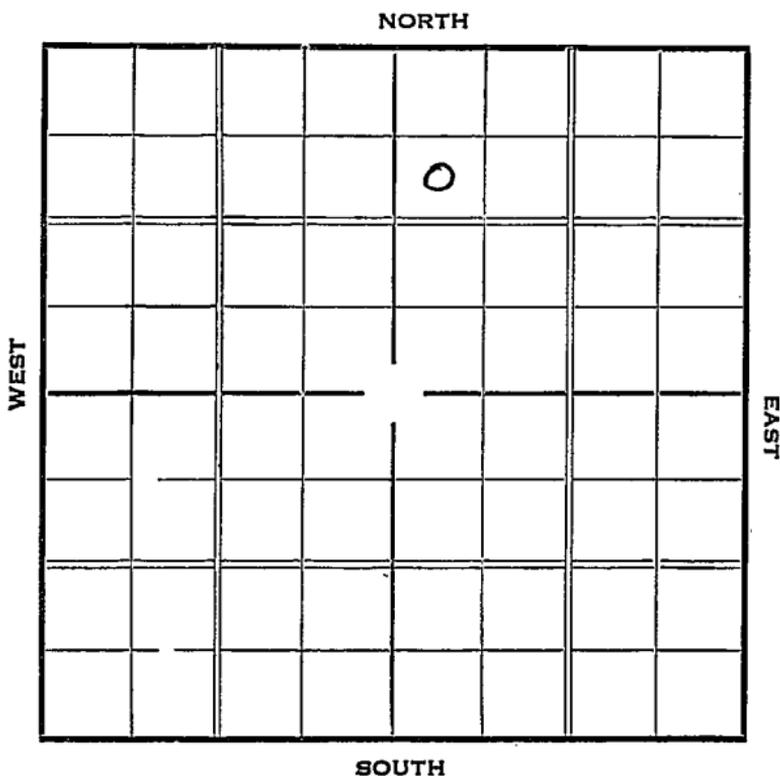

Sec. 10 Twp. 17 R. 11-W

Well No. #1 Kraft Farm

Price et al Company


990 Ft. from N. Line

\_\_\_\_\_ Ft. from S. Line

\_\_\_\_\_ Ft. from E. Line

330 Ft. from W. Line

Elev. 1869

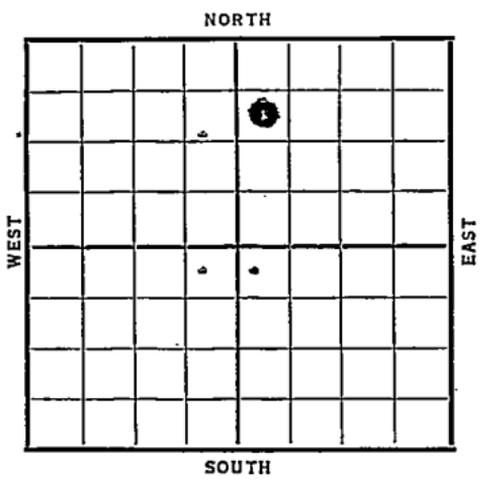

Date	REPORT
1/20	Rigging up
1/28	" "
2/4	" "
2/11	Shut down
2/19	15" @ 161. Drlg. 405'.
2/26	12" @ 463'. Drlg. 1030'.
3/4	Drlg. 1855'.
3/11	8" @ 1965', Drlg. 2315'.
3/18	Drlg. 2555'
3/25	Drlg. 2590'.
4/2	Drlg. 2925'.
4/8	Lansing 2990' SO & G 3025'
	SO & G 3130 1 Bailer water 3130
	TD 3226' Under ream 7"
4/16	" " " "
4/23	T.D. 3232'. 1600' oil.
	3000 acid. No test.
4/30	T.D. 3237'. Pumped 160 oil
	5 hours. Went to water.
	U. R. 6" pipe.
5/7	" " "
	<b>OVER</b>

1937

5/12 Sil. 3281'. 5" liner 3281'.  
2000' oil at 3284'.

H.F.O. at 3286 $\frac{1}{2}$ --3 hrs.

Swab.

5/21 Pumped 135 oil 1 $\frac{1}{2}$  hrs.  
Shut down for tanks.

5/26 6" @ 3181'.

5" liner 3281'. Sil. 3281'.

T.D. 3288 $\frac{1}{2}$ '..

Potential 1904 bbls.

**COMPLETED**

Map No. 53 Sec. 10 Twp. 17 R. 11W

Well No. 1 Kraft

Price & Tail Company

Contractor

**SECTION PLAT**

		0	

990 Ft. from N. Line

     Ft. from S. Line

     Ft. from E. Line

330 Ft. from W. Line

**FIRST REPORT**

Location \_\_\_\_\_

Rig up \_\_\_\_\_

Drilling and Remarks:

*Rigging up.*

**RECORD**

Cased \_\_\_\_\_ in., \_\_\_\_\_ ft.

Sand \_\_\_\_\_

Gas \_\_\_\_\_

Oil \_\_\_\_\_

Total Depth \_\_\_\_\_

**PRODUCTION**

1st 24 hrs. Nat. \_\_\_\_\_

1st 24 hrs. after shot \_\_\_\_\_

Gas \_\_\_\_\_ Cu. Ft.

Dry Hole \_\_\_\_\_

Abandoned \_\_\_\_\_

Date

JAN 20 1937<sub>19</sub>

S. J. LEWIS Scout

*Barton* KANSAS

Map No. \_\_\_\_\_ Sec. 10 Twp. 17 R. 11<sup>W</sup>

Well No. 1-Kraft

Price Oil Company

Contractor \_\_\_\_\_

**COMPLETED**

**SECTION PLAT**

990 Ft. from N. Line  
 \_\_\_\_\_ Ft. from S. Line  
 \_\_\_\_\_ Ft. from E. Line  
330 Ft. from W. Line

		0	

Location \_\_\_\_\_

Rig up \_\_\_\_\_

Drilling and Remarks:

*Pot 1904*

6" 3181  
**RECORD**  
 5" Liner  
 Cased \_\_\_\_\_ in., 3281 ft.  
 Sand 51 3281  
 Gas \_\_\_\_\_  
 Oil \_\_\_\_\_  
 Total Depth 3288 1/2

**PRODUCTION**

1st 24 hrs. Nat. \_\_\_\_\_  
 1st 24 hrs. after shot \_\_\_\_\_  
 Gas \_\_\_\_\_ -Cu. Ft.  
 Dry Hole \_\_\_\_\_  
 Abandoned \_\_\_\_\_

Date

MAY 26 1937 19

H. D. Hatfield

Scout