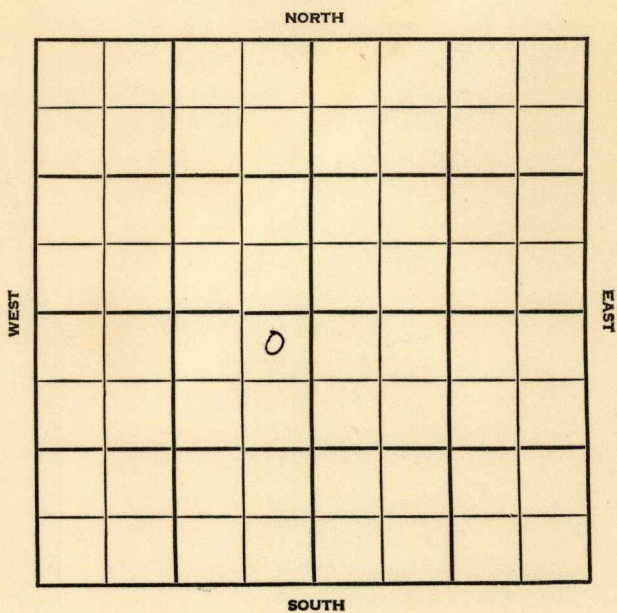


Section 31 Township 12 Range 16 WWell No. #1 BrungardtCompany Harms & Burt

Ellis

KANSAS

SEC. 31	TWP. 12	R. 16W
------------	------------	-----------

WELL NO.

#1 Brungardt

FARM

COMPANY

Harms & Burt

CONTRACTOR

Co. Tools

Wildcat


_____ Ft. from N. Line

_____ Ft. from S. Line

_____ Ft. from E. Line

_____ Ft. from W. Line

NE NE SW

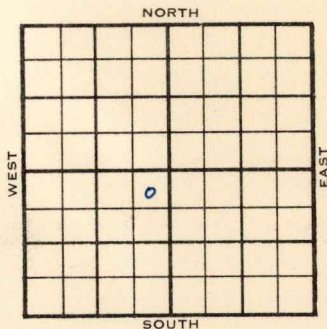

1955

ELEVATION

2036'

REPORT

9/7

Pits

9-21

Comm. 9-8-55

8 5/8" @ 160 w/125;

DST 3296-3329 op 1 hr., rec 35' mud
w/sso, BHP 30#;DST 3542-52 op 1 hr. rec. 100' sw,
BHP 840#

D & A

Tops: Anh. 1207

H. 3228

Dg. 3266

L. 3277


A 3541

T.D. 3585'

ABANDONED

County **Ellis** Elev. **2036**
 Sec. **31** Twp. **12S** Rge. **16W**
 Company **Harms & Burt**
 Farm Name **Brungardt** No. **1**

TOPS	DEPTH	LOG	DATUM	Loc. in Sec.
Anh.	1207			NE NE SW
Tp.				
H.	3228		1192	
Tr.				
Dg.	3266		1230	
Bl.				
L.	3277		1241	Geol.
K.C.				Contr.
B.K.C.				Co. tools
Ce.				
C.				Pool
M.				Wildcat
M.				
K.				
Mz.				
Me.				
V.				
S.				
S.	3541		1505	
A.				
R.				
Pe.				
G.				
T.D.	3585			

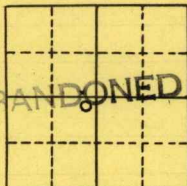

Date Comm. **9-8-55** SEP 21 1955

8-5/8" 160 w/125; DST 3296-3329 op 1 hr.
rec. 35' mud w/sso, BHp 30#; DST 3542-52
op 1 hr. rec. 100' sw, BHP 840#

D & A