


Section 10 Township 17 Range 11-W

Well No. 1 - Kroutwurst

Company Shell

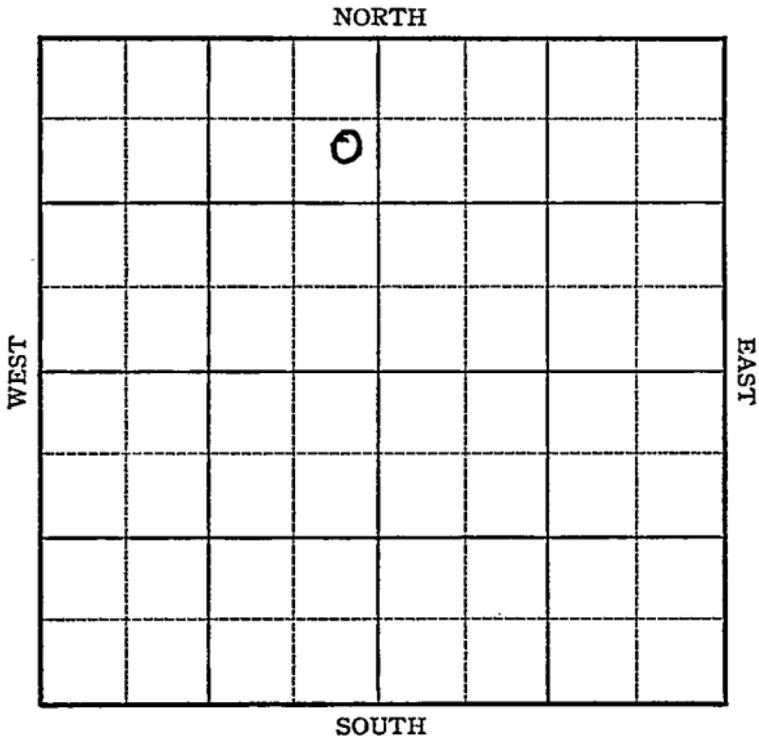

Barton KANSAS

Map No. _____ Sec. 10 Twp. 17 R. 11

Well No. 1 - Kroutwurst

Shell Company

Contractor _____

FIRST REPORT

914 Ft. from N. Line

_____ Ft. from S. Line

265 Ft. from E. Line

_____ Ft. from W. Line

SECTION PLAT

	0		

Location _____

Rig up _____

Drilling and Remarks:

cellar

RECORD

Cased _____ in., _____ ft.

Sand _____

Gas _____

Oil _____

Total Depth _____

PRODUCTION

1st 24 hrs. Nat. _____

1st 24 hrs. after shot _____

Gas _____ Cu. Ft.

Dry Hole _____

Abandoned _____

Date

AUG 18 1937₁₉

H. D. Hatfield Scout

KANSAS

Map No. _____ Sec. 10 Twp. 17 R. 11W

Well No. 1-Kroutwurst

Shell petroleum Company

Contractor _____

SECTION PLAT

	0		

914 Ft. from N. Line

_____ Ft. from S. Line

265 Ft. from E. Line

_____ Ft. from W. Line

COMPLETED

Location _____

Rig up _____

Drilling and Remarks:

Pumps 378 bbls 4 hrs
367 " " "

Pot. 2205
nat

RECORD

Cased _____ in., _____ ft.


Gas _____

Oil _____

Total Depth 3304

PRODUCTION

1st 24 hrs. Nat. _____

1st 24 hrs. after shot _____

Gas _____ Cu. Ft.

Dry Hole _____

Abandoned _____

Date

SEP 22 1937

H. D. Hatfield Scout