



Sec. 29 Twp. 12 R. 16W

Well No. #1 Miller Farm

M. B. Armer & NCRA Company

Armer- Contr. Contractor

Wildcat


Ft. from N. Line

330' Ft. from S. Line

330' Ft. from E. Line

Ft. from W. Line

SE SE SW

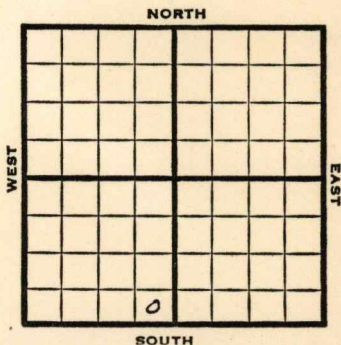

1951

Elev. 2039

REPORT

1/17

Spud 1-15-51

8" @ 195'

1/31

Spud 1/15/51

D & A TD 3610

8" @195'

Heeb. 3223 Toronto 3242 Lans. 3262

DST 3330-70 open 1 1/2 hr. Rec. 300'

mud & water

Cong. 3533 Arb. 3589

TD 3610

D & A

ABANDONED



