


Section 36 Township 24 Range 13-E

Well No. 1 Huston

Company H. H. Billerman

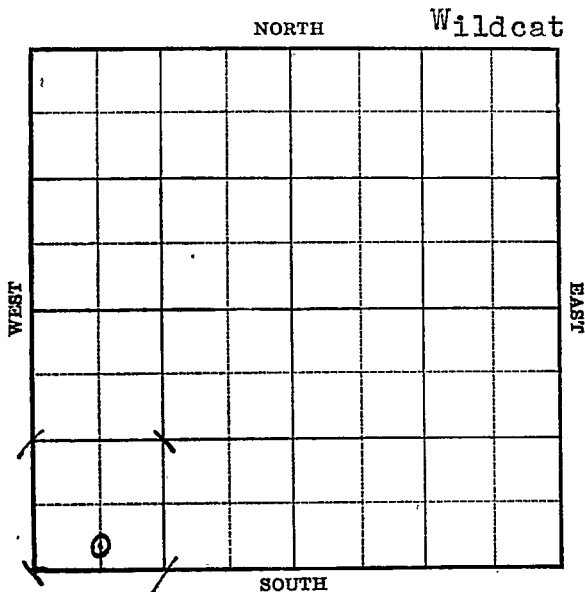



Map No. 17 Sec. 36 Twp. 24 R. 13EWell No. 1 HustonH. H. Billerman

Company

Contractor

## FIRST REPORT


## SECTION PLAT

C S L SW SW

\_\_\_\_\_ Ft. from N. Line

220 Ft. from S. Line

\_\_\_\_\_ Ft. from E. Line

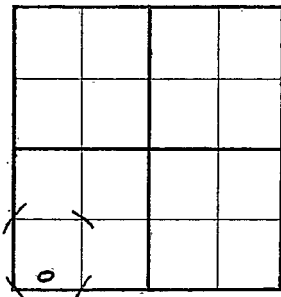660 Ft. from W. Line

WILDCAT

Location \_\_\_\_\_

Rig up \_\_\_\_\_

Drilling and Remarks:

Miss. 15296" 1529Drlg. 1555No Oil or Water

## RECORD

Cased \_\_\_\_\_ in., \_\_\_\_\_ ft.

Sand \_\_\_\_\_

Gas \_\_\_\_\_

Oil \_\_\_\_\_

Total Depth \_\_\_\_\_

## PRODUCTION

1st 24 hrs. Nat. \_\_\_\_\_

1st 24 hrs. after shot \_\_\_\_\_

Gas \_\_\_\_\_ Cu. Ft.

Dry Hole! \_\_\_\_\_

Abandoned \_\_\_\_\_

Date

APR 26 1939 19H. D. Hatfield Scout

Map No. 17 Sec. 36 Twp. 24 R. 13EWell No. 1 HustonH. H. Billerman

Company

Contractor

ABANDONED

C S L SW SW

SECTION PLAT

         Ft. from N. Line220 Ft. from S. Line         Ft. from E. Line660 Ft. from W. Line


Location                                 

RECORD

Cased          in.,          ft.Sand                                 Gas                                 Oil                                 Total Depth 1937

PRODUCTION

1st 24 hrs. Nat.                         1st 24 hrs. after shot                         Gas                                  Cu. Ft.Dry Hole                                 Abandoned                                 

Date

MAY 17 1939 19

S. J. LEWIS Scout