


Section 36 Township 24 Range 12-E
~~13-E~~

Well No. #1 King

Company P. L. Edwards

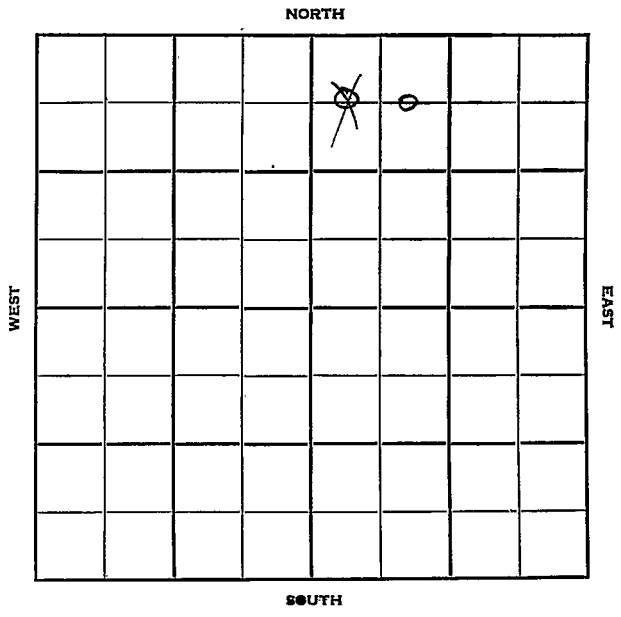

KANSAS 24

Woodson 12-E
~~13-E~~

36

Sec. _____ Twp. _____ R. _____

Well No. #1 King Farm _____

P. L. Edwards Company _____

Barrence Contractor _____


660 Ft. from N. Line

_____ Ft. from S. Line

_____ Ft. from E. Line

990
330 Ft. from W. Line

C ^E/_{WL} NW NE

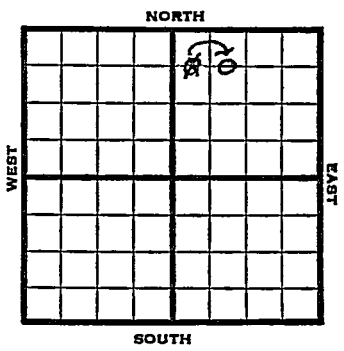

1951

Elev ?

REPORT

1/10

Spud 1-4-51

10" @ 400

Dr1g 550'

1/24

10" @ 400

8" @ 1179

Miss 1715

TD 1757

D&A

ABANDONED

Kansas

Map No. _____ Sec. 36 Twp. 24 R. 12E

Well No. 1 King

P. L. Edwards Company

CORRECTION Contractor

C E L NW NE

SECTION PLAT

660 Ft. from N. Line

_____ Ft. from S. Line

_____ Ft. from E. Line

990 Ft. from W. Line

		0	

Greenwood County

Location _____

Rig up _____

Drilling and Remarks:

Reported

C W L NW NE

36-24-13E

RECORD

Cased _____ in., _____ ft.

Sand _____

Gas _____

Oil _____

Total Depth _____

PRODUCTION

1st 24 hrs. Nat. _____

1st 24 hrs. after shot _____

Gas _____ Cu. Ft.

Dry Hole _____

Abandoned _____

Date

JAN 17 1951 19

J. F. TYRA Scout

County Greenwood State Kansas

Sec. 36 (Blk. Twp.) 24 (Sur. Rge.) 12E Map No.

Operator P. L. Edwards

Well No. 1 Farm King

Elev. Location C E L NW NE

660 Ft. From N Line NE

990 Ft. From W Line Quarter

1st. Report

Completion JAN 24 1951

Remarks

Barrence - Contr.

Spudding Date 1-4-51

Drig. Data D & A TD 1757

10" @ 400 8" @ 1179 Miss 1715 TD 1757

D & A