


Ellis

Section 33 Township 12 Range 16-W

Well No. 1 - Klotz

Company Bridgeport Mach.

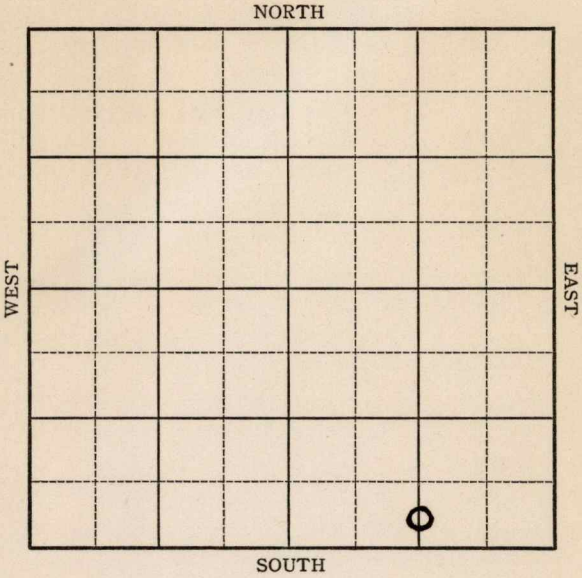

Sec. 33 Twp. 12 R. 16-W

Well No. #1 Klotz Farm


Bridgeport Mach. Company

 Ft. from N. Line

330 Ft. from S. Line

1320 Ft. from E. Line

 Ft. from W. Line

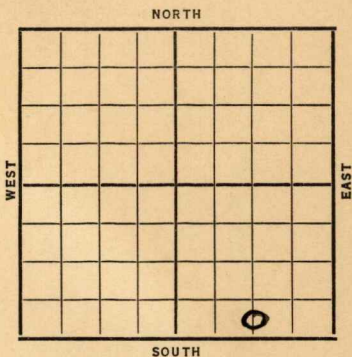

Elev. 2011

Date	REPORT
1937	
8/4	Cable Rig
8/13	Drlg. 335'.
8/20	15" @ 395'. Drlg. 455'.
8/28	12" @ 610'. T.D. 1050' Fsg.
9/3	Drlg. 1100'.
9/10	Anhy 1150'. 10" @ 1157'.
	Drlg. 1500'.
9/17	SD @ 1860'.
9/24	Drlg. 2410'.
10/2	8" @ 2569'. T.D. 2625'.
	U.R. 8".
10/8	Fsg. @ 2625'.
10/15	" "
10/22	" "
10/29	" "
11/5	" "
11/12	P.B. 2500'. Shot 10 qts.
	Damaged pipe. S.D.O.
11/19	" " " "
11/26	Fishing.

OVER

1937
 12/3 Fsg. 2500'.
 12/10 6" @ 2588'. T.D. 2609'.
 WOC.
 12/17 6" @ 2635'. Drlg. 2650'.
 12/24 " " " "
 12/31 Shut down.
 1938
 1/7 " "
 1/14 " "
 1/20 " "

 1/26 T.D. 2650'.
 Lost hole. Will skid rig.

ABANDONED

Ellis **KANSAS**

Map No. _____ Sec. 33 Twp. 12 R. 16^w

Well No. 1 - Klutz

Bridgeport mach. Company

Contractor _____

FIRST REPORT

SECTION PLAT

_____ Ft. from N. Line

330 Ft. from S. Line

1320 Ft. from E. Line

_____ Ft. from W. Line

Location _____

Rig up _____

Drilling and Remarks:

Cable Rig

RECORD

Cased _____ in., _____ ft.

Sand _____

Gas _____

Oil _____

Total Depth _____

PRODUCTION

1st 24 hrs. Nat. _____

1st 24 hrs. after shot _____

Gas _____ Cu. Ft.

Dry Hole _____

Abandoned _____

Date

AUG 4 - 1937 19

H. D. Hatfield Scout

Map No. _____ Sec. 33 Twp. 12 R. 16W

Well No. 1 Klotz

Bridgeport Machine Company

Contractor

ABANDONED

C S L SE

_____ Ft. from N. Line

330 Ft. from S. Line

1320 Ft. from E. Line

_____ Ft. from W. Line

SECTION PLAT

			○

Location _____

Rig up _____

Drilling and Remarks:

*Lost hole
will skid
rig
DVA*

RECORD

Cased _____ in., _____ ft.

Sand _____

Gas _____

Oil _____

Total Depth 2650

PRODUCTION

1st 24 hrs. Nat. _____

1st 24 hrs. after shot _____

Gas _____ Cu. Ft.

Dry Hole _____

Abandoned _____

Date

JAN 26 1938 19

H. D. Hatfield Scout