

SEC.	TWP.	R.
1	24	14E

WELL NO. #5 Stockebrand FARM

COMPANY John Haas

CONTRACTOR Co. Tools.

Hoagland Pool

330 990


Ft. from N. Line

Ft. from S. Line

Ft. from E. Line

330

Ft. from W. Line

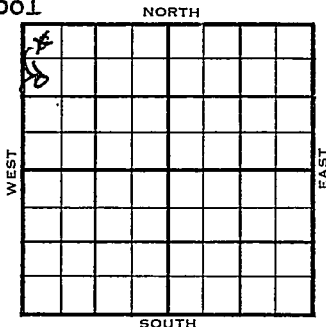

SW
NW NW NW

1954	ELEVATION	REPORT
	-	

11/3
12/1

RUCT
Spud 11-3-54
Oil Well
TD 1646'
7" @ 735'
6" @ 1150'
TD 1646'
5" @ 1633'
3000 A P/ 10 bo 40 bw 24 hr.
Comp 8 bopd. 40 bw.

COMPLETED

County **Woodson** State **Kansas**

Sec. **1** (Blk. **24**) (Sur. Rge.) **14E** Map No.

Operator **John Haas**

Well No. **5** Farm **Stochebrand**

Elev. Location **NW NW NW**

0							

330 Ft. From **N** Line **NW**

330 Ft. From **W** Line **Quarter**

Ist. Report **NOV 3 1954**

Completion

Remarks

Co. tools

Spudding Date

Hoagland Pool

Drlg. Data
RUCT

FABEN C. STRAP

Kansas

Map No. _____ Sec. 1 Twp. 24 R. 14E

Well No. 5 Stockebrand

John Haas Company

CORRECTION

Contractor

SW NW NW

SECTION PLAT

990 Ft. from N. Line

_____ Ft. from S. Line

_____ Ft. from E. Line

330 Ft. from W. Line

o			

Woodson County

Location _____

Rig up _____

Drilling and Remarks:

Reported

NW NW NW

RECORD

Cased _____ in., _____ ft.

Sand _____

Gas _____

Oil _____

Total Depth _____

PRODUCTION

1st 24 hrs. Nat. _____

1st 24 hrs. after shot _____

Gas _____ Cu. Ft.

Dry Hole _____

Abandoned _____

Date

DEC 1 1954 19

FABEN GILSTRAP
Scout

