


Section 1 Township 24 Range 14-E

Well No. #1 Stockerbrand "B"

Company Ward McGinnis

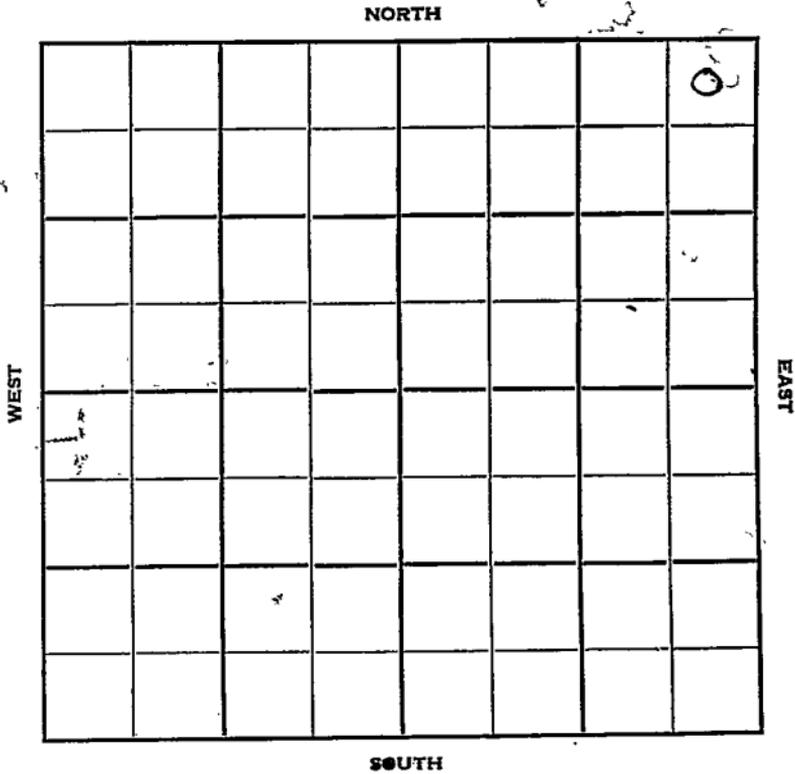

1

24

14-EV

Sec. _____ Twp. _____ R. _____

Well No. #1 Stockerbrank "B" Farm _____

Ward McGinnis Company _____

Layton Contractor _____


330 Ft. from N. Line

Ft. from S. Line

330 Ft. from E. Line

Ft. from W. Line

NE NE NE

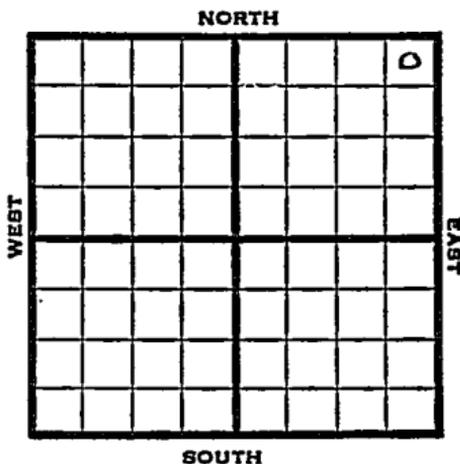

1951

REPORT

Elev.

1/10

Spud 1-6-51
Drlg 411'

1/31

Spud 1/6/51
Oil well TD 1575
Miss 1543-70
4" @1555 TD 1575
3000 A
Comp. 10 bopd

COMPLETED

