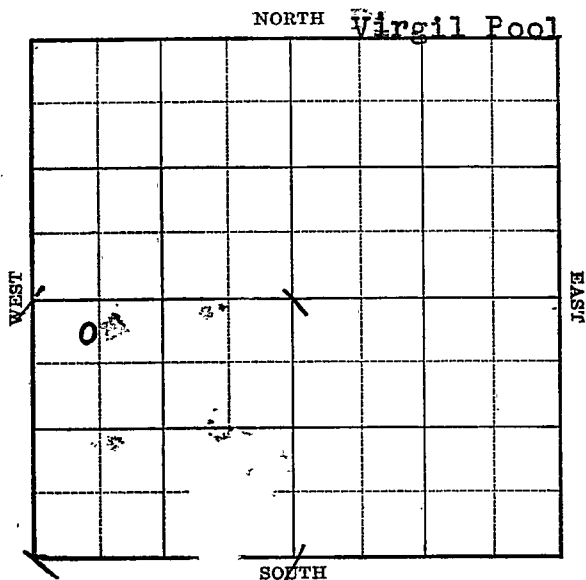


Section 1 Township 24 Range 14-EWell No. #1 WiedeCompany Aikman & Son

[illegible]

KANSAS

Form 26—1M Bks.—2-29

Woodson

Map No. 17 Sec. 1 Twp. 24 R. 14EWell No. 1 WiedeAikman & Son

Company

Contractor

FIRST REPORT

6 N L NW SW

SECTION PLAT

350 Ft. from N. Line Ft. from S. Line Ft. from E. Line520 Ft. from W. Line

VIRGIL POOL

Location

RECORD

Cased in., ft.Sand Gas Oil Total Depth

Drilling and Remarks:

10" @ 4008" @ 1010Dr1g. 1500

PRODUCTION

1st 24 hrs. Nat. 1st 24 hrs. after shot Gas Cu. Ft.Dry Hole Abandoned

Date

MAY 17 1939 19

S. J. LEWIS

Scout

Map No. 17 Sec. 1 Twp. 24 R. 14EWell No. 1 WiedeAikman & Son

Company

Contractor

COMPLETED


C N L NW' SW

SECTION PLAT

350 Ft. from N. Line

_____ Ft. from S. Line

_____ Ft. from E. Line

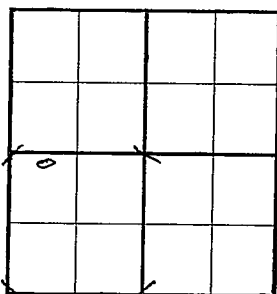520 Ft. from W. Line

VIRGIL POOL

Location _____

Rig up _____

Drilling and Remarks: _____

Miss 1616
6" @ 1628.
1500 acid
Pump 7886

RECORD

Cased _____ in., _____ ft.

Sand _____

Gas _____

Oil _____

Total Depth 1639.

PRODUCTION

1st 24 hrs. Nat. _____

1st 24 hrs. after shot _____

Gas _____ Cu. Ft.

Dry Hole _____

Abandoned _____

Date

JUL 12 1939

S. J. LEWIS

Scout