


Section 1 Township 24 Range 14E
~~15E~~

Well No. # 2 Weide

Company P. L. Edwards

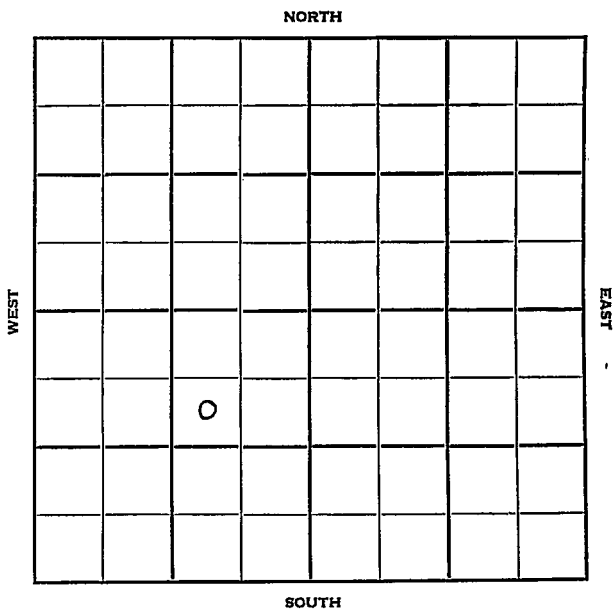

Woodson

KANSAS 14E
15E

Sec. 1 Twp. 24 R. 15E

Well No. #2 Weide Farm

P. L. Edwards Company

Contractor


990' Ft. from N. Line

Ft. from S. Line

990' Ft. from E. Line

Ft. from W. Line

SW NE SW

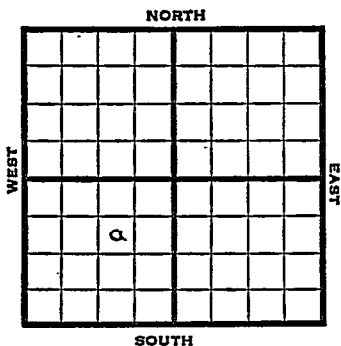

1951

Elev. -

REPORT

3/28

Spud 3-26-51

4/18

Spud 3-26-51
D&A TD 1630
10" @ 740
8" @ 973
Miss 1619
D&A

ABANDONED

Map No. _____ Sec. 1 Twp. 24 R. 14EWell No. 2 WeideP. L. Edwards Company

CORRECTION

Contractor

SW NE SW

SECTION PLAT

990 Ft. from N. Line

_____ Ft. from S. Line

990 Ft. from E. Line

_____ Ft. from W. Line

	0		

Woodson County

Location _____

Rig up _____

Drilling and Remarks:

Reported

1-24-15E

RECORD

Cased _____ in., _____ ft.

Sand _____

Gas _____

Oil _____

Total Depth _____

PRODUCTION

1st 24 hrs. Nat. _____

1st 24 hrs. after shot _____

Gas _____ Cu. Ft.

Dry Hole _____

Abandoned _____

Date

APR 11 1951

19

J. E. TYRA

Scout

