


Section 34 Township 12 Range 16W

Well No. #1 Froelich

Company Kewanee Oil

NORTH

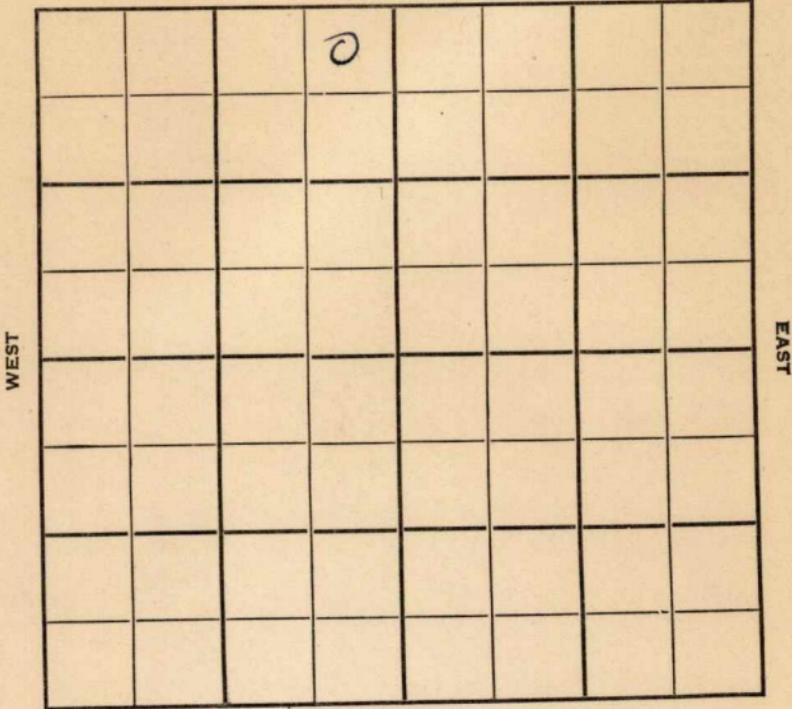

SOUTH

Ellis

KANSAS

Sec. 34 Twp. 12 R. 16W ✓

Well No. #1 Froelich Farm

Kewanee Oil Company

Contractor


Wildcat

330' Ft. from N. Line

Ft. from S. Line

330' Ft. from E. Line

Ft. from W. Line

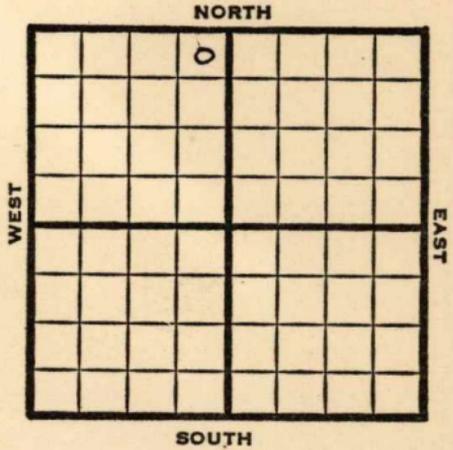

NE NE NW

1950

**Elev 2062**

REPORT

6/14

MIM

7/19

8" @ 502

Anhy 1210

Heeb 3222

Dodge 3242

Lans 3273

Arb 3530-31 SO

5" @ 3530

TD 3535

FU 2650' oil in 17 hr

Comp 239 bopd

Completed

**COMPLETED**

Map No. \_\_\_\_\_ Sec. 34 Twp. 12 R. 16W

Well No. 1 Froelich

Kewanee Oil Company

Contractor

NE NE NW

SECTION PLAT

330 Ft. from N. Line

Ft. from S. Line

330 Ft. from E. Line

Ft. from W. Line



Ellis County

CRA acreage

Location \_\_\_\_\_

Rig up \_\_\_\_\_

Drilling and Remarks:

M I M

RECORD

Cased \_\_\_\_\_ in., \_\_\_\_\_ ft.

Sand \_\_\_\_\_

Gas \_\_\_\_\_

Oil \_\_\_\_\_

Total Depth \_\_\_\_\_

PRODUCTION

1st 24 hrs. Nat. \_\_\_\_\_

1st 24 hrs. after shot \_\_\_\_\_

Gas \_\_\_\_\_ Cu. Ft.

Dry Hole \_\_\_\_\_

Abandoned \_\_\_\_\_

Date

JUN 14 1950 19

J. E. TYRA Scout

**Kansas**

Wildcat

Map No. \_\_\_\_\_ Sec. 34 Twp. 12 R. 16W

Well No. 1 Froelich

\_\_\_\_\_ Kewanee Oil \_\_\_\_\_ Company

\_\_\_\_\_ Contractor

NE NE NW

E1. 2062  
SECTION PLAT

330 Ft. from N. Line

\_\_\_\_\_ Ft. from S. Line

330 Ft. from E. Line

\_\_\_\_\_ Ft. from W. Line

	0		

COMPLETE

Ellis County

Location \_\_\_\_\_

Rig up \_\_\_\_\_

Drilling and Remarks:

8" @ 502

Anhy 1210

Heeb. 3222

Dodge 3242

Lans. 3273

Arb. 3530-31 SO

5" @ 3530

**RECORD**

Cased \_\_\_\_\_ in., \_\_\_\_\_ ft.

Sand \_\_\_\_\_

Gas \_\_\_\_\_

Oil \_\_\_\_\_

Total Depth 3535

**PRODUCTION**

1st 24 hrs. Nat. \_\_\_\_\_

1st 24 hrs. after shot \_\_\_\_\_

Gas \_\_\_\_\_ Cu. Ft.

Dry Hole \_\_\_\_\_

Abandoned \_\_\_\_\_

Date 7 19 1950

**JUL 19 1950** 19

J. E. TYRA Scout

