


Section 10 Township 17 Range 11-W

Well No. 1 Stueder

Company Carter

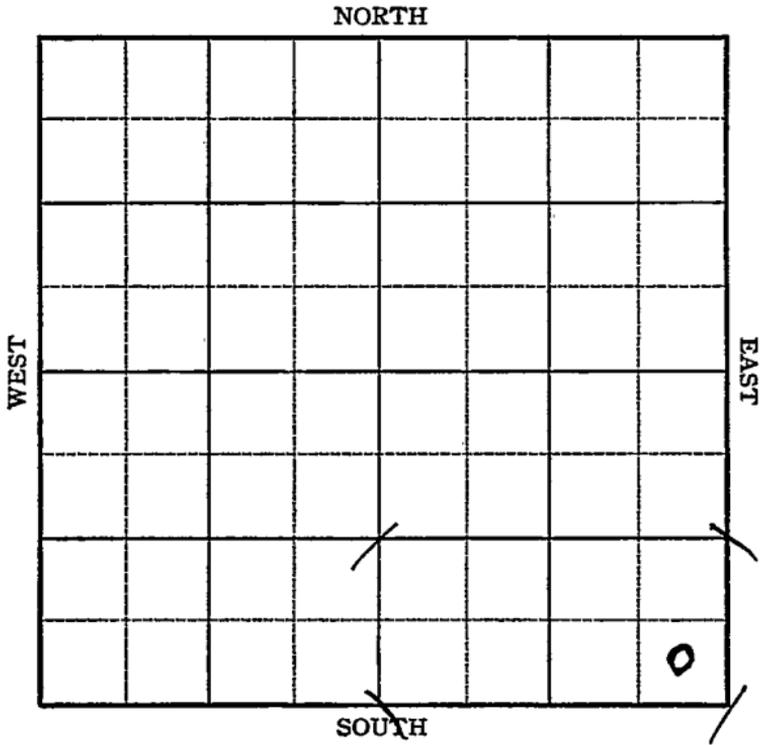

Sec. 10 Twp. 17 R. 11-W

Well No. #1 Stueder Farm

Carter Company


_____ Ft. from N. Line

330 Ft. from S. Line

330 Ft. from E. Line

_____ Ft. from W. Line

Elev. 1875

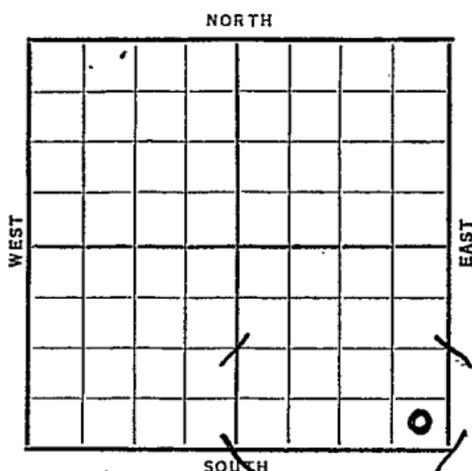

Date	REPORT
1937	
12/15	Location
12/24	R U R
12/31	10" @ 232'. Drlg. 615'.
1938	
1/7	Drlg. 2530'.
1/14	K.C. 3022' Sm. S.O. 3250-58'. Coring 3290'.
1/20	Arb. 3325' T.D. 3335'
	Spotted Sat. 6"-3325' R.U.ST.
1/26	6" @ 3325'.
	Arb. 3325'.
	T.D. 3335'.
	Potential 1807 bbls.
	COMPLETED

Map No. 55 Sec. 10 Twp. 17 R. 11WWell No. 1 StuederCarter

Company

Contractor

FIRST REPORT**SE/C** Ft. from N. Line330 Ft. from S. Line330 Ft. from E. Line Ft. from W. Line**SECTION PLAT**

Location XRig up

Drilling and Remarks:

RECORDCased in., ft.Sand Gas Oil Total Depth **PRODUCTION**1st 24 hrs. Nat. 1st 24 hrs. after shot Gas Cu. Ft.Dry Hole Abandoned

Date

DEC 15 1937H. D. Hatfield Scout

Barton KANSAS

Map No. _____ Sec. 10 Twp. 17 R. 11WWell No. 1 Stueder_____
Carter Company_____
Contractor

COMPLETED

SE/C

SECTION PLAT

Ft. from N. Line330
Ft. from S. Line330
Ft. from E. Line_____
Ft. from W. Line

			0

Location _____

Rig up _____

Drilling and Remarks:

POT-1807

RECORD

Cased 6 in., 3325 ft.Sand A-6 3325

Gas _____

Oil _____

Total Depth 3335

PRODUCTION

1st 24 hrs. Nat. _____

1st 24 hrs. after shot _____

Gas _____ Cu. Ft.

Dry Hole _____

Abandoned _____

Date

JAN 26 1938₁₉H. D. Hatfield Scout