


Section 34 Township 12 Range 16-W

Well No. #2 Froelich "A"

Company Kewanee Oil

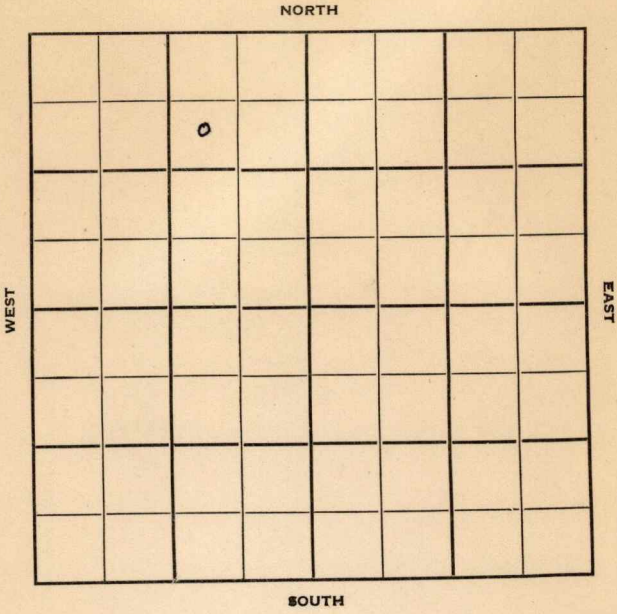

KANSAS

Ellis

Sec. 34 Twp. 12 R. 16-W

Well No. #2 Froelich "A" Farm

Kewanee

Company

Gross Supply

Contractor

Emerman

990

Ft. from N. Line


Ft. from S. Line

990

Ft. from E. Line

Ft. from W. Line

SW NE NW

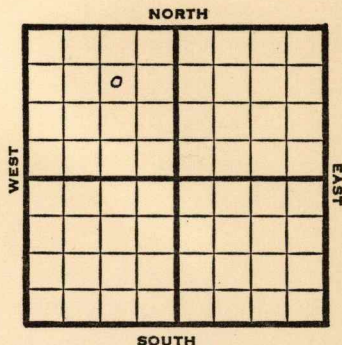

1950

Elv. 2050'

REPORT

10/18 Cellar & Pits

12/13

Spud 10-18-50

Oil Well TD 3513

8" @ 218' Anhy 1192-1230

KC 3354'

DST 3300-3305 opn $\frac{1}{2}$ hr Rec. 35' sw

4' oil Arb. 3511'

5" @ 3512' TD 3513

FU 2380' oil in hole

Comp. 430 bopd

COMPLETED

County Ellis State Kansas

Sec.	34	(Blk. Twp.)	12	(Sur. Rge.)	16W	Map No.
------	----	----------------	----	----------------	-----	---------

Operator Kewanee Oil

Well No. 2 Farm Froelich "A"

Elev.	2050	Location	SW NE NW
-------	------	----------	----------

990 Ft. From N Line NW

990 Ft. From E Line Quarter

1st. Report

Completion DEC 13 1950

Remarks Emmerman Pool

Gross Supply - Contr.

Spudding Date 10-18-50

Drlg. Data Oil well TD 3513

8" @ 218 Anhy 1192-1230 KC 3354

DST 3300-3305 open $\frac{1}{2}$ hr. Rec. 35' sw

4' oil Arb. 3511 5" @ 3512 TD 3513

FU 2380' oil in hole

Comp. 430 bopd