


Map No. K Sec. 2 Twp. 24 R. 14^E

Well No. #1 Allen Farm
Iowa Kansas Company
Lima Iowa

_____ Ft. from N. Line
1120 Ft. from S. Line
200 Ft. from E. Line
 _____ Ft. from W. Line

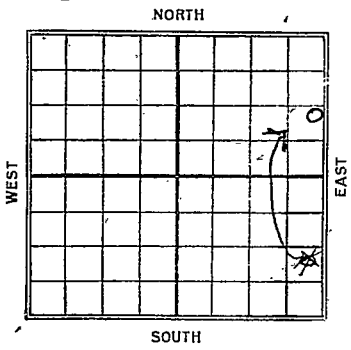

Date	REPORT.
1924	
11/12	6 5/8" @ 1609
11/19	Pay 1613-20 T.D. 1623'
	Swabbed 120 Bbls
	1st 24 hours 3.9 Gravity
11/26	send 1613-20 T.D. 1623 Pumping
	.75 Bbls 3.9 Gravity

Map No. *W 24* Sec. *2* Twp. *24* R. *14 E*

Well No. *# 1 Allen*

Tawa Kansas Company

Contractor

FIRST REPORT

SECTION PLAT

----- Ft. from N. Line

1120' Ft. from S. Line

200' Ft. from E. Line

----- Ft. from W. Line

			0

Location -----

Rig up -----

Drilling and Remarks:

6 3/8 1609'

RECORD

Cased ----- in., ----- ft.

Sand -----

Gas -----

Oil -----

Total Depth -----

PRODUCTION

1st 24 hrs. Nat. -----

1st 24 hrs. after shot -----

Gas ----- Cu. Ft.

Dry Hole -----

Abandoned -----

Date
NOV 12 1924

M. A. BENEAR

Map No. **KANSAS** Sec. 2 Twp. 24 R. 14E

Well No. 1 Allen

Louis Lala Company

Contractor

*was reported as
Tower Kansas*

SECTION PLAT

			0
			↑
			0

_____ Ft. from N. Line

1120' Ft. from S. Line

200' Ft. from E. Line

_____ Ft. from W. Line

COMPLETED

Note Correction

RECORD

Location _____

Rig up _____

Drilling and Remarks:

sand 1613-20

T.D. 1623

pumping

75' hld 39

Gravity Oil.

Cased _____ in., _____ ft.

Sand _____

Gas _____

Oil _____

Total Depth _____

PRODUCTION

1st 24 hrs. Nat. _____

1st 24 hrs. after shot _____

Gas _____ Cu. Ft.

Dry Hole _____

Abandoned _____

Date NOV 26 1924

M. A. BENEAR