


DX 78-1 Woodson

KANSAS

Section 2 Township 24 Range 11E  
Well No. #1 Edwards  
Company John Haas

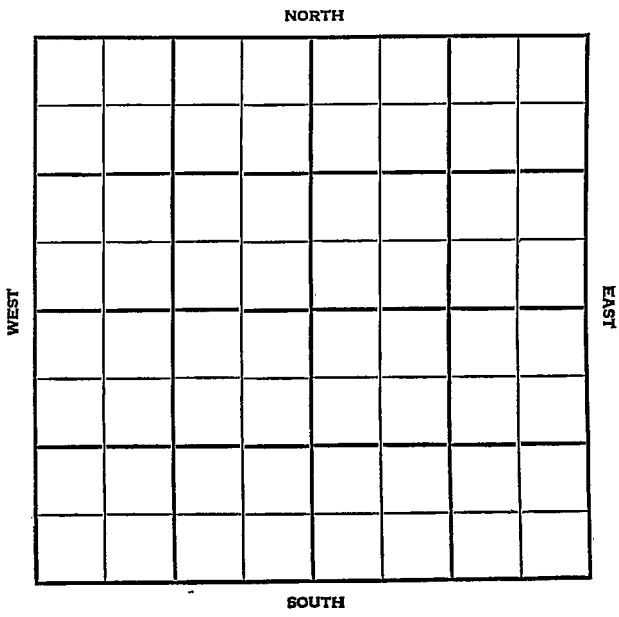



County Woodson Elev. \_\_\_\_\_  
 Sec. 2 Twp. 24 Rge. 14E  
 Company John Hays  
 FarmName Edwards No. 1

TOPS	DEPTH	LOG	DATUM
Anb.			
TP.			
H.			
Tr.			
Dg.			
Bl.			
L.			
K.C.			
B.K.C.			
Ce.			
C.			
M.			
M.			
K.			
Mz.			
Me.			
V.			
S.			
S.			
A.			
R.			
PE.			
G.			
T.D.			

Loc. in Sec. \_\_\_\_\_  
NW NW NW  
250' NL  
175' WT.  
 Geol. \_\_\_\_\_  
 Contr. \_\_\_\_\_  
Co. tools  
 Pool \_\_\_\_\_  
Winterscheid  

0		

 FIRST REPORT  
 MAR 21 56

Date Comm. 2-18-56  
drlg. 250

*(Handwritten scribble)*

Co.  
Lse.  
No.  
Sec.  
T.  
R.

County Woodson Elev. 1130  
 Sec. 2 Twp. 24 Rge. 14E  
 Company John Haas  
 FarmName Edwards No. 1

TOPS	DEPTH	LOG	DATUM
Anh.			
Tp.			
H.			
Tr.			
Dg.			
Bl.			
L.			
K.C.			
B.K.C.			
Ce.			
C.			
M. <u>Chat</u>	<u>1673</u>		<u>543</u>
M. <u>sm</u>	<u>1685</u>		<u>555</u>
K.			
Mz.			
Mq.			
V.			
S.			
S.			
A.			
R.			
PE.			
G.			
TR.	<u>1722</u>		

Loc. in Sec. NW NW NW  
250' NL  
175' WL  
 Geol. \_\_\_\_\_  
 Contr. \_\_\_\_\_  
Co. tools  
 Pool \_\_\_\_\_  
Winterscheid  

0		

**ABANDONED**

Date Comm. 2-18-56 APR 1 8 1956  
8" @ 972

D & A

Co.  
 Use.  
 No.  
 Sec.  
 T.  
 R.