

Butler


FORM 51

KANSAS

Section 36 Township 29 Range 1E


Well No. #1 Mahlandt

Company Stelbar Oil

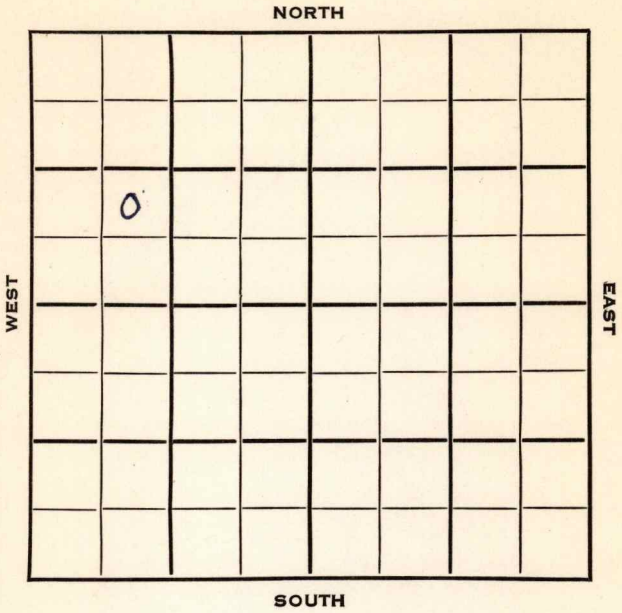

Butler KANSAS
SEC. 36 TWP. 29 R. 4 E
WELL NO.
1 Mahlandt FARM
COMPANY
Stelbar Oil
CONTRACTOR
Stelbar

Ft. from N. Line
990 Ft. from S. Line
Ft. from E. Line
990 Ft. from W. Line

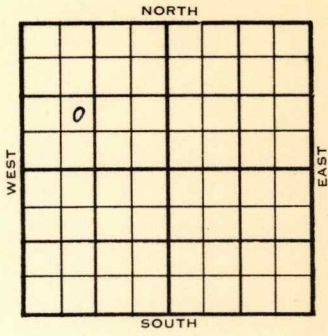

NE SW NW

	ELEVATION	REPORT
1954	1258'	
1/20	Spud 1-16-54 8" @ 42	
2/3	Drlg. 321' Spud 1-16-54 8" @ 42' KC 2235', Bart. 2768' TD 2789' D & A	

ABANDONED

County Butler State KansasSec. 36 (Blk. Twp.) 29 (Sur. Rge.) 4E Map No. _____Operator Stelbar OilWell No. 1 Farm MahlandtElev. 1258 Location NE SW NW990 Ft. From S Line NW990 Ft. From W Line Quarter

1st. Report _____

Completion FEB 3 1954

Remarks _____

Stelbar - Contr.Spudding Date 1-16-54

Drlg. Data

8" @ 42 KC 2235 Bart. 2768 TD 2789D & A