


Section 36 Township 29 Range 4E

Well No. #1 Stolebarger

Company Stelbar Oil

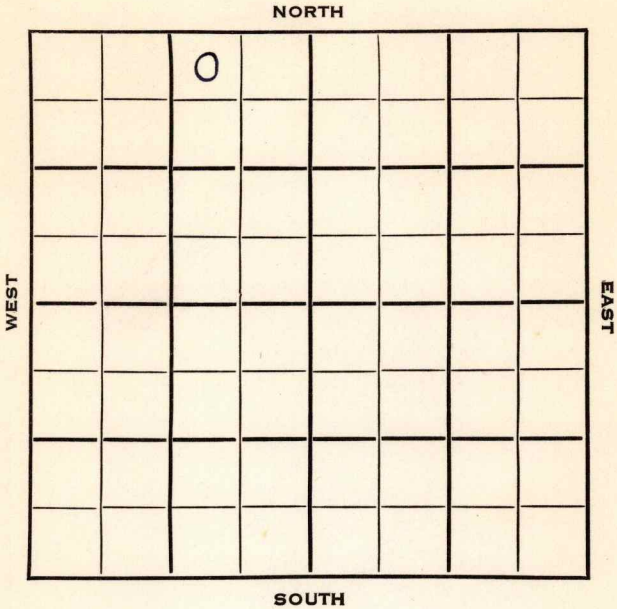

Sec. 36 Twp. 29 R. 4E

Well No. #1 Stolebarger Farm

Stelbar Oil Company

Stelbar Wildcat Contractor


330 Ft. from N. Line

Ft. from S. Line

717 Ft. from E. Line

Ft. from W. Line

NW NE NW

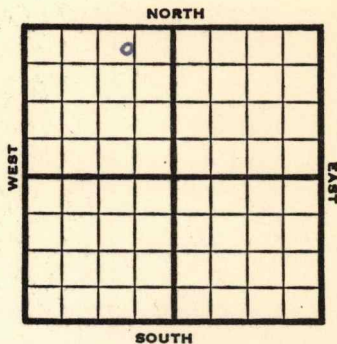

1953

Elev. 1244' REPORT

8/19 RUR

9/30 Spud 8-18-53

Oil Well

TD 2784'

8" @ 61'

Stal. 1850', KC 2228', Bart 2757,

TD 2774'

5" @ 2757'

DD 2784'

PB 2774'

Hydro. S/ 2 1/2 boph

Comp. 25 bopd.

COMPLETED

County **Butler** State **Kansas**

Sec. **36** (Blk. Twp.) **29** (Sur. Rge.) **4E** Map No.

Operator **Stelbar Oil**

Well No. **1** Farm **Stolebarger**

Elev. Location **NW NE NW**

	0				

**330** Ft. From **N** Line **NW**

**717** Ft. From **E** Line **Quarter**

1st. Report **AUG 19 1953**

Completion

Remarks

**Stelbar - Contr.**

Spudding Date

Drilg. Data **Wildcat**

**RUR**

J. G. McGEHEE

