


Section 35 Township 29 Range 4E

Well No. 1 Spicer

Company Stelbar Oil

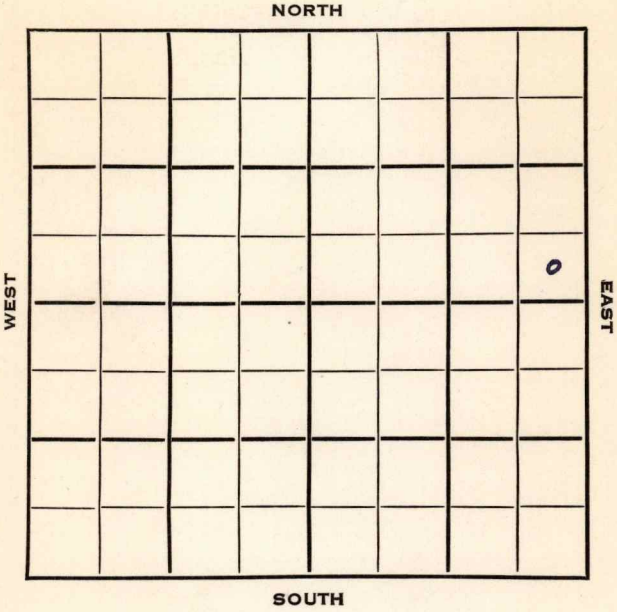

Butler

KANSAS


| | | | |
|------------|------------|-----------|---|
| SEC. 35 | TWP. 29 | R. 4 E | ✓ |
|------------|------------|-----------|---|

WELL NO. # 1 Spicer FARM

COMPANY Stelbar Oil

CONTRACTOR Stelbar

_____ Ft. from N. Line
 330 _____ Ft. from S. Line
 330 _____ Ft. from E. Line
 _____ Ft. from W. Line

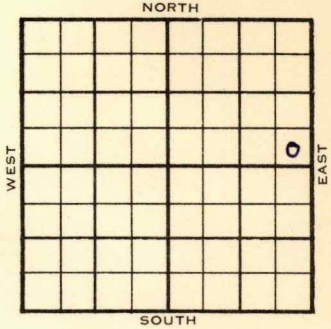

SE SE NE

| | | |
|------|-----------|--------|
| 1954 | ELEVATION | REPORT |
|------|-----------|--------|

5/5 RUR
 6/2 Spudding 5-4-54
 Oil well
 TD 2768
 8" @ 44
 KC 2225 Cherokee 2678Bart.2759
 TD 2768
 5" @ 2762
 CO to 2768 sd@oil-frac Comp. 25bopd

COMPLETED

County **Butler** State **Kansas**

Sec. **35** (Blk. **29** (Sur. **4E** Map No. (Twp.) (Rge.)

Operator **Stelbar Oil**

Well No. **1** Farm **Spicer**

Elev. Location **SE SE NE**

| | | | | | |
|--|--|--|--|--|--|
| | | | | | |
| | | | | | |
330 Ft. From **S** Line **NE**

330 Ft. From **E** Line Quarter

1st. Report **MAY 5 1954**

Completion

Remarks

Stelbar - Contr.

Spudding Date

FIRST REPORT

Drig. Data

R U R

County Butler State Kansas

Sec. 35 (Blk. 29) (Sur. 4E) Map No.

Operator Stelbar Oil

Well No. 1 Farm Spicer

Elev. 1252 Location SE SE NE

| | | | | | |
|--|--|--|--|--|--|
| | | | | | |
| | | | | | |
330 Ft. From S Line NE

330 Ft. From E Line Quarter

Ist. Report

Completion JUN 2 1954

Remarks

Stelbar - Contr.

Spudding Date 5-4-54

Drlg. Data Oil well TD 2768

8" @ 44 KC 2225 Cherokee 2678

Bart. 2759 TD 2768 5" @ 2762

CO to 2768 sd-oil-frac Comp. 25 bopd

COMPLETED

J. G. McGEHEE