


Map No. KANSAS Sec. 2 Twp. 24 R. 14E

Well No. 2-Hogland Farm
Oko Oil Co Company

NORTH

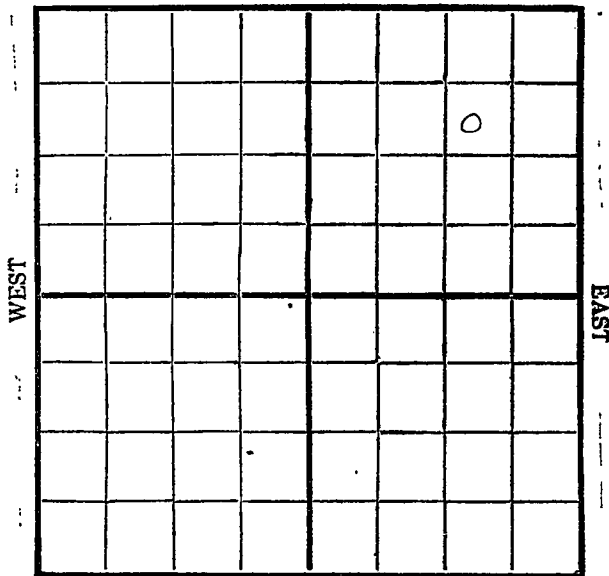

SOUTH

Location _____

Drilling Remarks

RECORD

Cased _____ in. _____ ft.
Sand _____
Gas _____
Oil _____
Total Depth _____

Rig Up _____

Drilling Remarks

PRODUCTION

1st 24 hrs. Nat. _____
1st 24 hrs. after shot _____
Gas _____ cu. ft. _____
Dry Hole _____
Abandoned _____

Hoodson

Map No. KANSAS Sec. 2 Twp. 24 R. 14^E


Well No. 2- Hogueland Farm
Okro Oil Company

1070 Ft. from N. Line

_____ Ft. from S. Line

1070 Ft. from E. Line

_____ Ft. from W. Line

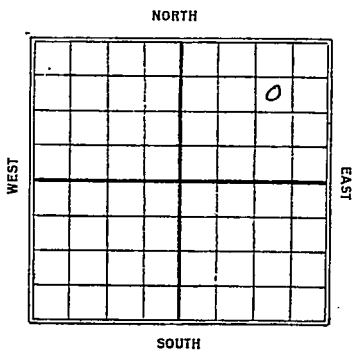

1930

Date	REPORT
1/8	Rigin up
1/15	—
1/22	—
1/29	—
2/4	Spdg.
2/11	Culdg. 515
2/19	750
2/26	Top line 1603'
3/5	Drng 6" csq Sand 1647-57'
	(Top line 1620)
	T.D. 1657
	shot 20 at 35 lbs oil Comp.

Woodson

KANSAS
 Map No. _____ Sec. *2* Twp. *24* R. *14*^E

Well No. *17* *2 Hogueland.*

Okla Oil Co Company

Contractor

FIRST REPORTS

1070 Ft. from N. Line

_____ Ft. from S. Line

1070 Ft. from E. Line

_____ Ft. from W. Line

SECTION PLAT

			<i>0</i>

Location _____

Rig up *Rigs up*

Drilling and Remarks:

RECORD

Cased _____ in., _____ ft.

Sand _____

Gas _____

Oil _____

Total Depth _____

PRODUCTION

1st 24 hrs. Nat. _____

1st 24 hrs. after shot _____

Gas _____ Cu. Ft.

Dry Hole _____

Abandoned _____

Date

JAN 8 1930

CHAS. L. SHERWOOD

192

Scout

Woodson

17 KANSAS Map No. Sec. 2 Twp. 24 R. 14

Well No. 2 Hogueland
Oko Oil Co Company

Contractor

COMPLETE

SECTION PLAT

1070 Ft. from N. Line
Ft. from S. Line
1070 Ft. from E. Line
Ft. from W. Line

			o

Location

Rig up

Drilling and Remarks:

top here 1650

70/35 Bls.

RECORD

Cased in., ft.
Sand 1647-1657
Gas
Oil
Total Depth 1657

PRODUCTION

1st 24 hrs. Nat.
1st 24 hrs. after shot
Gas Cu. Ft.
Dry Hole
Abandoned

Date

MAR 5 1930

CHAS. L. SHERWOOD

192

Scout