


DX 78-1

Section 35 Township 29 Range 4E

Well No. 3 Spicer

Company Stelbar Oil

NORTH

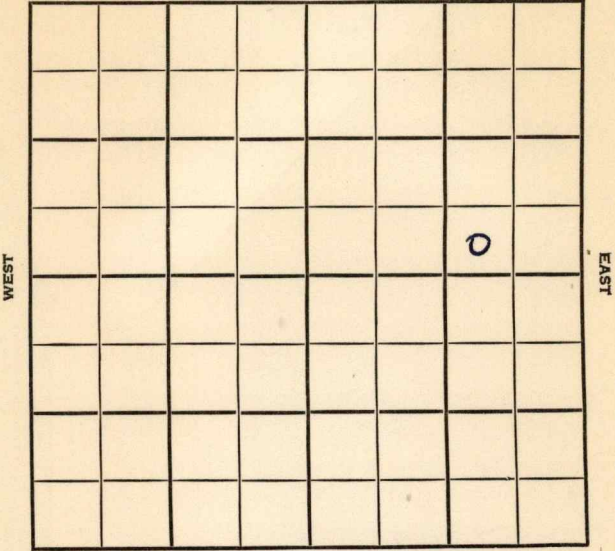

SOUTH

Butler KANSAS


SEC. 35 TWP. 29 R. 4E

WELL NO. 3 Spicer FARM

COMPANY Stelbar Oil

CONTRACTOR

Ft. from N. Line
330 Ft. from S. Line
990 Ft. from E. Line
Ft. from W. Line

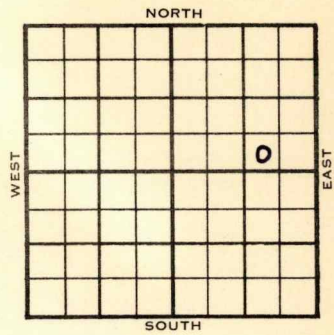

SW SE NE

ELEVATION 1954 REPORT 1257

7/21 Cellar & Pits
8/4 Spdg 7-21-54
8" @ 53
KC 2230 Bart. 2763
TD 2773
D&A

ABANDONED



County Butler State Kansas

Sec. 35 (Blk.) 29 (Sur.) 4E Map No.   
 (Twp.) (Rge.)

Operator Stelbar Oil

Well No. 3 Farm Spicer

Elev. 1257 Location SW SE NE

|  |  |  |  |  |  |
|--|--|--|--|--|--|
|  |  |  |  |  |  |
|  |  |  |  |  |  |
330 Ft. From S Line NE

990 Ft. From E Line Quarter

Ist. Report

Completion AUG 4 1954

Remarks

Spudding Date 7-21-54

Drlg. Data

8" @ 53 KC 2230 Bart. 2763 TD 2773

D & A