


Section 36 Township 29 Range 4 E

Well No. # 1 Mahlandt

Company Stelbar Oil

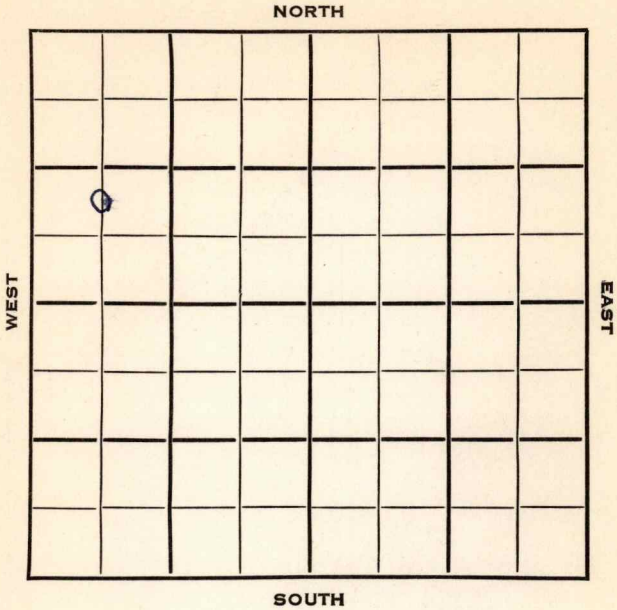

Butler

KANSAS

SEC.

36

TWP.

29

R.

4 E



WELL NO.

1 Mahlandt

FARM

COMPANY

Stelbar Oil

CONTRACTOR

Mt. Tabor Pool

Ft. from N. Line

990


Ft. from S. Line

Ft. from E. Line

660

Ft. from W. Line

C N L SW NW

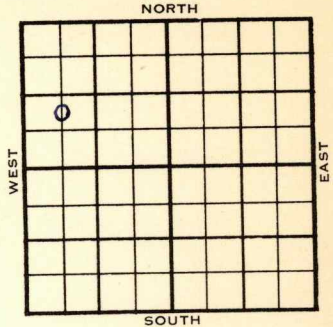

1954

ELEVATION

1260' RB

REPORT

2/17

D & A TD 2789'

8" @ 43 KC 2235' Bart. 2768'

TD 2789' D & A

FIRST REPORT

✓

ABANDONED

County Butler State Kansas
 Sec. 36 (Blk.) 29 (Sur.) 4E Map No.
 Operator Stelbar Oil
 Well No. 1 Farm Mahlandt
 Elev. 1260 RB Location C N L SW NW



990 Ft. From S Line NW
660 Ft. From W Line Quarter
 1st. Report FEB 17 1954
 Completion FEB 17 1954
 Remarks

Spudding Date

Drlg. Data D & A TD 2789 Mt. Tabor Pool
8" @ 43 KC 2235 Bart. 2768 TD 2789
D & A

J. G. McGEHEE