


Section 36 Township 29 Range 4E

Well No. 2 Mahlandt

Company Stelbar Oil

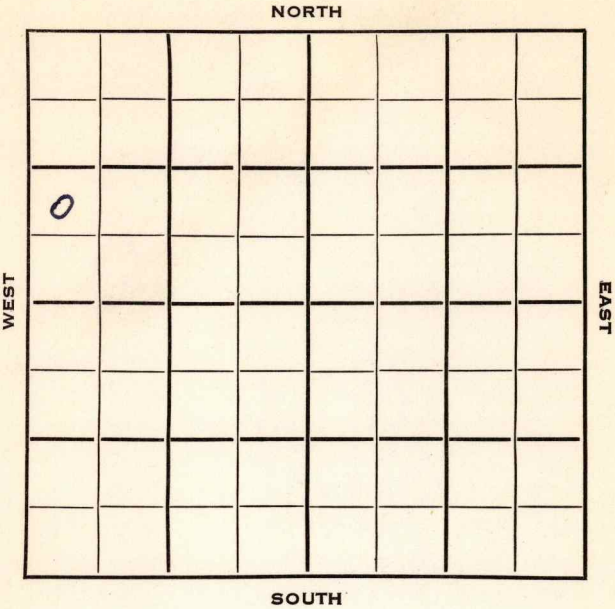

SEC.	TWP.	R.
36	29	4E ✓

WELL NO.

2 Mahlandt

FARM

COMPANY

Stelbar Oil

CONTRACTOR

Stelbar


Mt. Tabor Pool

_____ Ft. from N. Line

990 _____ Ft. from S. Line

_____ Ft. from E. Line

330 _____ Ft. from W. Line

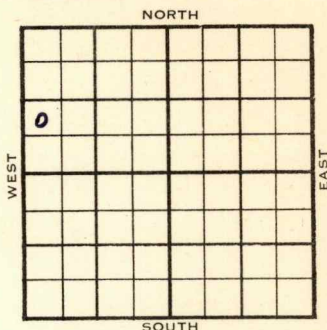

NW SW NW

ELEVATION

REPORT

1954

1264'

4/7

Spud 4-3-54

8" @ 50'

Drlg. 365'

5/5

Spud 4-3-54 Oil well TD 2784

8" @ 50 Stal. 1860 KC 2240

B KC 2477 Cherokee 2679 Bart. 2772

TD 2780 5" @ 2772 DD 2784

PB 2780 frac. Comp. 50 BOPD

COMPLETED

County Butler State KansasSec. 36 (Blk. 29 (Sur. 4E Map No.Operator Stelbar OilWell No. 2 Farm MahlandtElev. Location NW SW NW

0							

990 Ft. From S Line NW330 Ft. From W Line Quarter1st. Report APR 7 1954

Completion

Remarks

Stelbar - Contr.Spudding Date 4-3-54Drlg. Data Mt. Tabor Pool8" @ 50 drlg. 365

County Butler State KansasSec. 36 (Blk.
Twp.) 29 (Sur.
Rge.) 4E Map No.Operator Stelbar OilWell No. 2 Farm MahlandtElev. 1264 Location NW SW NW

0							

990 Ft. From S Line NW330 Ft. From W Line Quarter1st. ReportCompletion MAY 5 1954Remarks Mt. Tabor PoolStelbar - Contr.Spudding Date 4-3-54Drlg. Data Oil well TD 27848" @ 50 Stal. 1860 KC 2240 B KC 2477Cherokee 2679 Bart. 2772 TD 27805" @ 2772 DD 2784 PB 2780 fracComp. 50 bopd

J. G. McGEHEE