


Section 36 Township 29 Range 4E

Well No. 1 Parks

Company Dunn & Strait

Wildcat

NORTH

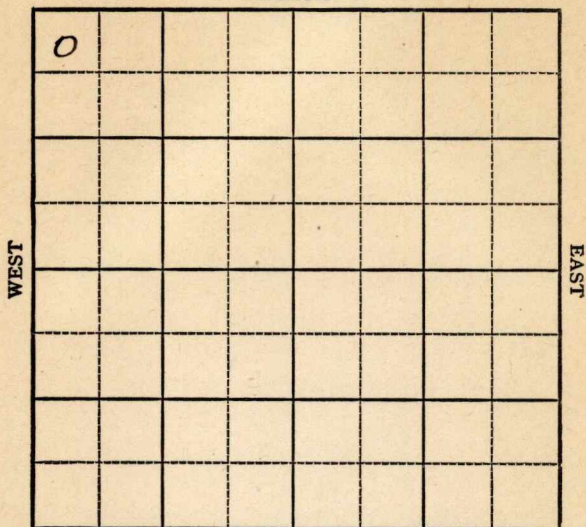

SOUTH

Sec. 36 Twp. 29 R. 4E ✓

Well No. 1 Parks Farm

Dunn & Strait Company

Wildcat


330 Ft. from N. Line

_____ Ft. from S. Line

_____ Ft. from E. Line

330 Ft. from W. Line

NW/C

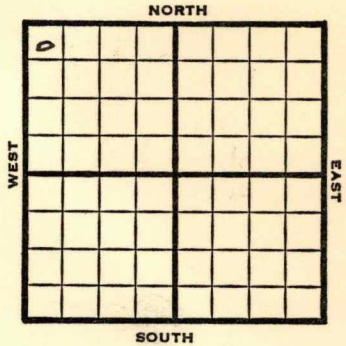

1948

Eli 1265'

REPORT

11/17 Location

11/23 Mach

11/30 Drlg. 685'

12/6 12" @ 840'

Drlg. 1392'

12/14 10" @ 1882'

8" @ 1995'

Drlg. 2005'

12/22 **KC 2240'**

Drlg. 2580'

12/29 TD 2890'

Miss 2885'

Aband.

ABANDONED

Map No. _____ Sec. 36 Twp. 29 R. 4E

Well No. 1 Parks

Dunn & Strait Company

FIRST REPORT Contractor

NW/C

SECTION PLAT

330 Ft. from N. Line

_____ Ft. from S. Line

_____ Ft. from E. Line

330 Ft. from W. Line

b			

Butler County

Location x

Rig up _____

Drilling and Remarks:

RECORD

Cased _____ in., _____ ft.

Sand _____

Gas _____

Oil _____

Total Depth _____

PRODUCTION

1st 24 hrs. Nat. _____

1st 24 hrs. after shot _____

Gas _____ Cu. Ft.

Dry Hole _____

Abandoned _____

Date

NOV 17 1948 19

S. J. LEWIS Scout

Map No. 11 Sec. 36 Twp. 29 R. 4E

Well No. 1 Parks

Dunn & Strait Company

ABANDONED

Contractor

NW/C

E 11265
SECTION PLAT

330 Ft. from N. Line

_____ Ft. from S. Line

_____ Ft. from E. Line

330 Ft. from W. Line

6			

Butler County

Location _____

Rig up _____

Drilling and Remarks:

Miss 2885

RECORD

Cased _____ in., _____ ft.

Sand _____

Gas _____

Oil _____

Total Depth 2890

PRODUCTION

1st 24 hrs. Nat. _____

1st 24 hrs. after shot _____

Gas _____ Cu. Ft.

Dry Hole _____

Abandoned _____

Date

DEC 29 1948

19

S. J. LEWIS

Scout