

Map No. *Butler* **KANSAS** Sec. *36* Twp. *29* R. *4^E*

Well No. *1-Park* Farm

Empire Oil Co. Company

NORTH

WEST

EAST

			0				

SOUTH

Location.....

Drilling Remarks

.....

.....

RECORD

Cased..... in..... ft.

Sand.....

Gas.....

Oil.....

Total Depth.....

Rig Up.....

Drilling Remarks

.....

.....

PRODUCTION

1st 24 hrs. Nat.....

1st 24 hrs. after shot.....

Gas..... cu. ft.....

Dry Hole.....

Abandoned.....


Butler
 Map No. **KANSAS** Sec. *36* Twp. *29* R. *4^E*
 Well No. *1- Parks* Farm
Empire O & K Company

330 Ft. from N. Line

..... Ft. from S. Line

330 Ft. from E. Line

..... Ft. from W. Line

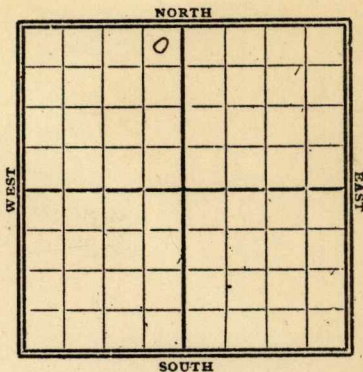

1929

Date

REPORT

<i>6/19</i>	<i>Location</i>
<i>6/26</i>	<i>Bldg Reg</i>
<i>7/2</i>	<i>100 yds up</i>
<i>7/10</i>	<i>Spdy</i>
<i>7/17</i>	<i>dry 745'</i>
<i>7/24</i>	<i>" 1375'</i>
<i>7/31</i>	<i>" 2055'</i>
<i>8/7</i>	<i>setg 8"-2365'</i>
<i>8/14</i>	<i>sdys shape 2759-66'</i>
	<i>show oil</i>
	<i>dry 2880'</i>
<i>8/21</i>	<i>T</i>
<i>8/28</i>	<i>dry 2990</i>
<i>9/4</i>	<i>base line 3158</i>
	<i>Top Viola 3280</i>
	<i>HFW 3284' dry 3310</i>
<i>9/11</i>	<i>Top Viola 3280'</i>
	<i>HFW 3284'</i>
	<i>T.D. 3375 1/2'</i>
	<i>Abandoned</i>

MAP NO. **KANSAS** SEC. 36 TWP. 29 R. 4E
WELL NO. 1 Parks

Empire Oil & Ref. COMPANY
CONTRACTOR

SECTION PLAT

		0		

330 FT. FROM N. LINE

FT. FROM S. LINE

330 FT. FROM E. LINE

FT. FROM W. LINE

FIRST REPORTS

LOCATION ✓

RIG UP

DRILLING AND REMARKS:

RECORD

CASED IN. FT.

SAND

GAS

OIL

TOTAL DEPTH

PRODUCTION

1ST 24 HRS. NAT.

1ST 24 HRS. AFTER SHOT

GAS CU. FT.

DRY HOLE

ABANDONED

DATE

JUN 19 1929

192

SCOUT

CHAS. L. SHERWOOD

Map No. **KANSAS** Sec. 36 Twp. 29 R. 4Well No. 1 Empire

Company

Contractor

COMPLETE330 Ft. from N. Line Ft. from S. Line330 Ft. from E. Line Ft. from W. Line**ABANDONED****SECTION PLAT**

Location Rig up

Drilling and Remarks:

Tap Viola 3280
AFW 3284

RECORDCased in., ft.Sand Gas Oil Total Depth 3375 1/2**PRODUCTION**1st 24 hrs. Nat. 1st 24 hrs. after shot Gas Cu. Ft.Dry Hole ☒Abandoned ☒

Date

SEP 1 1 1929

CHAS. L. SHERWOOD