


Section 36 Township 29 Range 4 E

Well No. # 2 Stolebarger

Company Stelbar Oil

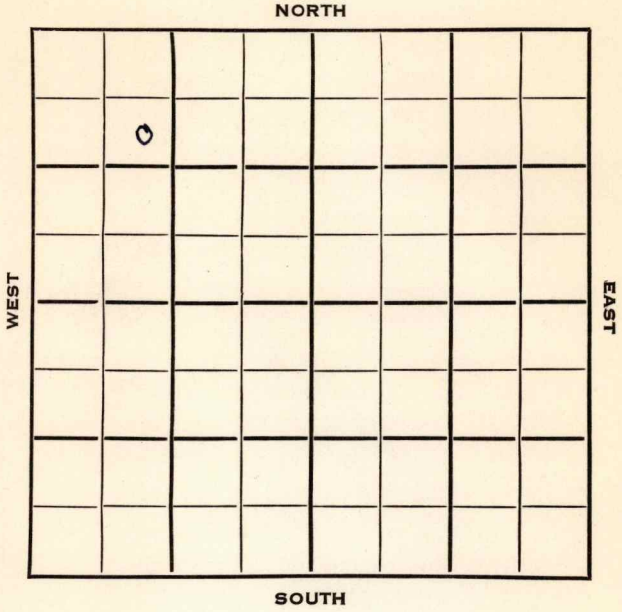

SEC.	TWP.	R.
36	29	4E ✓

WELL NO. 2 Stolebarger FARM

COMPANY Stelbar Oil

CONTRACTOR Stalbar


Tabor Pool

990 Ft. from N. Line

_____ Ft. from S. Line

_____ Ft. from E. Line

1100 Ft. from W. Line

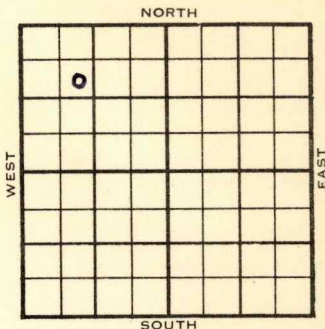

SE NW NW

	ELEVATION	REPORT
1953	1251'	

12/2 Spud 11-28-53
8" @ 61'
D rlg. 200'

12/22 Spud 11-28-53
Oil Well
TD 2775'
8" @ 61'
Bart 2761', KC 2227'
TD 2774'
5" @ 2762'
DD 2775' frac
Comp 25 bopd.

COMPLETED

County Butler State Kansas

Sec. 36 (Blk. 29 (Sur. 4E (Twp. 29 (Rge. 4E Map No.

Operator Stelbar Oil

Well No. 2 Farm Stolebarger

Elev. _____ Location SE NW NW

0					
FIRST REPORT					

990 Ft. From N Line NW

1100 Ft. From W Line Quarter

1st. Report DEC 2 1953

Completion _____

Remarks _____

Stelbar - Contr.

Spudding Date 11-28-53

Drlg. Data Tabor Pool

8" @ 61 drlg. 200

