

Map No. 7 Sec. 1 Twp. 29 R. 5


Well No. 1 Haygart Farm
Boss Oil Company

_____ Ft. from N. Line

200 Ft. from S. Line

1120 Ft. from E. Line

_____ Ft. from W. Line

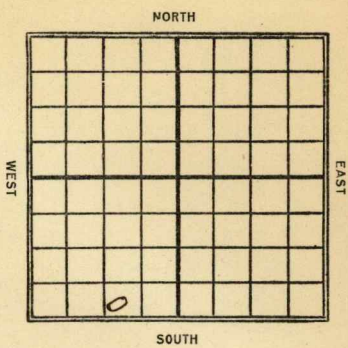

Date	REPORT
<u>1922</u>	
<u>2/18</u>	<u>Run up</u>
<u>3/30</u>	<u>Sand 2804-2834 Shot</u>
	<u>10 qts 135 bbls 1st 24</u>
	<u>hrs. after shot T.P. 2834</u>

Kansas

Map No. K11 Sec. 1 Twp. 29 R. 5

Well No. 1 Haggart

Base Oil Company

Contractor

COMPLETED

SECTION PLAT

----- Ft. from N. Line

200 Ft. from S. Line

1120 Ft. from E. Line

----- Ft. from W. Line

Location -----

Rig up -----

Drilling and Remarks:

sand 2804-34
shot 100 ft
133 ft
1st 24 hrs
after shot

RECORD

Cased ----- in., ----- ft.
 Sand -----
 Gas -----
 Oil -----
 Total Depth 2734

PRODUCTION

1st 24 hrs. Nat. -----
 1st 24 hrs. after shot -----
 Gas ----- Cu. Ft.
 Dry Hole -----
 Abandoned -----

Date .

MAR 30 1922 191 -----

M. A. BENEAR Scout

Map No. K11 Sec. 1 Twp. 29 R. 5

Well No. 1 Haggart

Boes Oil Co. Company

Contractor

Butler Co.

SECTION PLAT

FIRST REPORT

----- Ft. from N. Line

200 Ft. from S. Line

1120 Ft. from E. Line

----- Ft. from W. Line

Location -----

Rig up -----

Drilling and Remarks:

Rigs up.

RECORD

Cased ----- in., ----- ft.

Sand -----

Gas -----

Oil -----

Total Depth -----

PRODUCTION

1st 24 hrs. Nat. -----

1st 24 hrs. after shot -----

Gas ----- Cu. Ft.

Dry Hole -----

Abandoned -----

Date
FEB 18 1922

M. A. BENEAR
FIRST REPORT