

STATE CORPORATION COMMISSION OF KANSAS OIL & GAS CONSERVATION DIVISION

WELL COMPLETION OR RECOMPLETION FORM ACO-1 WELL HISTORY

DESCRIPTION OF WELL AND LEASE

Operator: license # 9629 name Griffin Resources, Inc. address 100 S. Main, Suite 200 City/State/Zip Wichita, KS 67202

Operator Contact Person Van F. Griffin Phone (316) 262-1641

Contractor: license # 5147 name BEREDCO INC.

Wellsite Geologist Mike Freeman Phone (316) 684-4820

Signate Type of Completion [X] New Well [ ] Re-Entry [ ] Workover

[ ] Oil [ ] SWD [ ] Temp Abd [ ] Gas [ ] Inj [ ] Delayed Comp. [X] Dry [ ] Other (Core, Water Supply etc.)

If OWWO: old well info as follows: Operator Well Name Comp. Date Old Total Depth

WELL HISTORY

Drilling Method: [X] Mud Rotary [ ] Air Rotary [ ] Cable 11-14-85 11-20-85 11-20-85 Start Date Date Reached TD Completion Date

4149' Total Depth PBSD

Amount of Surface Pipe Set and Cemented at 302 7 1/2 ft. feet

Multiple Stage Cementing Collar Used? [ ] Yes [X] No If Yes, Show Depth Set feet

If alternate 2 completion, cement circulated from feet depth to w/ SX cmt

API NO. 15 - 135-22,969 County NESS 248' S NE (location) Sec 36 Twp. 16S Rge. 21W West

3712.... Ft North from Southeast Corner of Section 1320.... Ft West from Southeast Corner of Section (Note: locate well in section plat below)


Lease Name MCNAMEE "A" Well# 1

Field Name Davenport

Producing Formation

Elevation: Ground 2195' KB 2200'

Section Plat

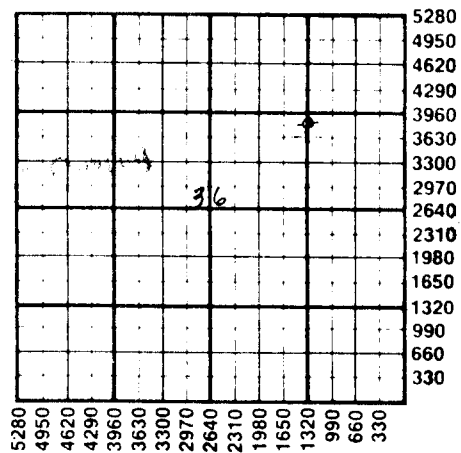

WATER SUPPLY INFORMATION

Source of Water:

Division of Water Resources Permit #

[ ] Groundwater Ft North From Southeast Corner and (Well) Ft. West From Southeast Corner of Sec Twp Rge [ ] East [ ] West

[ ] Surface Water Ft North From Southeast Corner and (Stream, Pond etc.) Ft West From Southeast Corner Sec Twp Rge [ ] East [ ] West

[X] Other (explain) Wellbrocks Tank Service (purchased from city, R.W.D.#)

Disposition of Produced Water: [ ] Disposal [ ] Repressuring

Docket #

INSTRUCTIONS: This form shall be completed in duplicate and filed with the Kansas Corporation Commission, 200 Colorado Derby Building, Wichita, Kansas 67202, within 90 days after completion or recompletion of any well. Rules 82-3-130 and 82-3-107 apply.

Information on side two of this form will be held confidential for a period of 12 months if requested in writing and submitted with the form. See rule 82-3-107 for confidentiality in excess of 12 months.

One copy of all wireline logs and drillers time log shall be attached with this form. Submit CP-4 form with all plugged wells. Submit CP-111 form with temporarily abandoned wells.

SIDE TWO

Operator Name Griffin Resources Lease Name MCNAMEE A Well# 1 SEC 36 TWP. 16S RGE. 41W

East  
 West

**WELL LOG**

**INSTRUCTIONS:** Show important tops and base of formations penetrated. Detail all cores. Report all drill stem test giving interval tested, time tool open and closed, flowing and shut-in pressures, whether shut-in pressure reached static level, hydrostatic pressures, bottom hole temperature, fluid recovery, and flow rates if gas to surface during test. Attach extra sheet if more space is needed. Attach copy of log.

Drill Stem Tests Taken  Yes  No  
 Samples Sent to Geological Survey  Yes  No  
 Cores Taken  Yes  No

**Formation Description**  
 Log  Sample

DST #1 4001-4056'; Rec. 1361' total fluid; 1' free oil, 280' watery mud w/scum of oil, 1080' water; IFP 164-360#; FFP 442-565#; ISIP 925#; FSIP 925#; IHP 2008#; FHP 1956#.

Name	Top	Bottom
Anhy.	1464'	(+736)
Heebner	3562'	(-1362)
Pawnee	3952'	(-1752)
Lab. Sh.	4014'	(-1814)
Ft. Sc.	4030'	(-1830)
Cher. Sd.	4050'	(-1850)
Unc.	4134'	(-1850)
LTD	4148'	(-1934)

CASING RECORD <input type="checkbox"/> new <input type="checkbox"/> used							
Report all strings set - conductor, surface, intermediate, production, etc.							
Purpose of string	size hole drilled	size casing set (in O.D.)	weight lbs ft.	setting depth	type of cement	# sacks used	type and percent additives
Surface	12-1/4"	8-5/8"	23#	302'	60-40 poz.	225	6% gel

PERFORATION RECORD		Acid, Fracture, Shot, Cement Squeeze Record	
shots per foot	specify footage of each interval perforated	(amount and kind of material used)	Depth