


Section 10 Township 17 Range 11-W

Well No. 2 Kroutwurst

Company Carter Oil

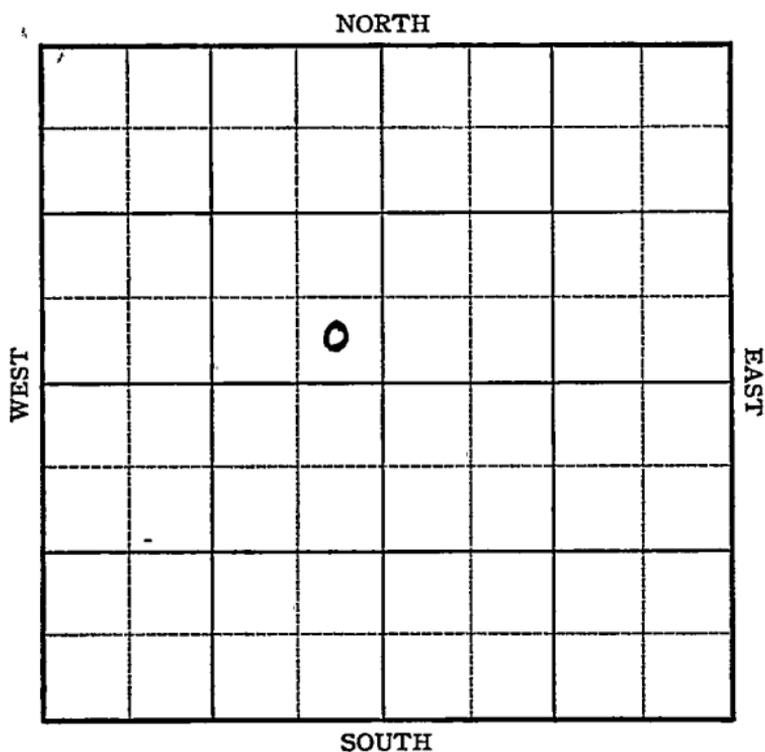

Sec. 10 Twp. 17 R. 11-W

Well No. #2 Kroutwurst Farm

Carter Oil Company


 Ft. from N. Line

330 Ft. from S. Line

330 Ft. from E. Line

 Ft. from W. Line

Elev. 1869

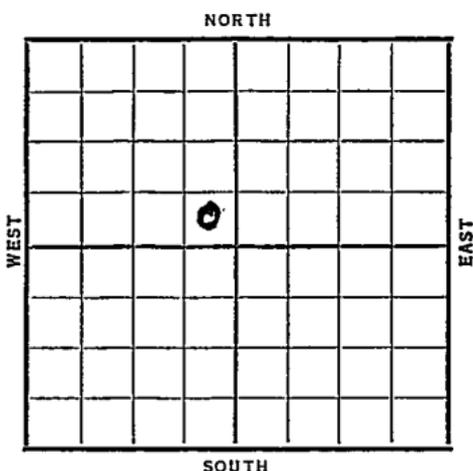

Date	REPORT
1937	
12/8	R. R.
12/17	R U R
12/24	10" @ 229'. Drlg. 1088'.
12/31	Drlg. 2602'.
1938	
1/7	Arb. 3300'. T.D. 3307'.
	Spotted Sat. Rng. 7".
1/14	7" @ 3300'. Drlg. plug.
1/20	1900' oil @ 3312 @ 3315 pumped
	194 oil in 8 hrs 2000 acid
	Pumped 16 bbls oil P.H.
	T.D. 3326 pumped 241bbls oil in
	8 hrs.
OVER	

1938

1/26

7" @ 3300'.

Arb. 3300'.

T.D. 3326'.

2000 acid.

Potential 881 bbls.

COMPLETED

Map No. _____ Sec. 10 Twp. 17 R. 11W

Well No. 2 Kroutwurst

Carter Oil Company

Contractor

FIRST REPORT

SE NW

_____ Ft. from N. Line

330 Ft. from S. Line

330 Ft. from E. Line

_____ Ft. from W. Line

SECTION PLAT

		0	

Location _____

Rig up _____

Drilling and Remarks:

RR

RECORD

Cased _____ in., _____ ft.

Sand _____

Gas _____

Oil _____

Total Depth _____

PRODUCTION

1st 24 hrs. Nat. _____

1st 24 hrs. after shot _____

Gas _____ Cu. Ft.

Dry Hole _____

Abandoned _____

Date

DEC 8 - 1937 19

H. D. Hatfield

Scout

Barton **KANSAS**Map No. _____ Sec. 10 Twp. 17 R. 11WWell No. 2 KroutwurstCarter

Company

Contractor

COMPLETED**SE NW**

_____ Ft. from N. Line

330 Ft. from S. Line330 Ft. from E. Line

_____ Ft. from W. Line

SECTION PLAT

		0	

Location _____

Rig up _____

Drilling and Remarks:

*2000 acid**POT-881***RECORD**Cased 7 in., 3300 ft.Sand Arb 3300

Gas _____

Oil _____

Total Depth 3326**PRODUCTION**

1st 24 hrs. Nat. _____

1st 24 hrs. after shot _____

Gas _____ Cu. Ft.

Dry Hole _____

Abandoned _____

Date

JAN 26 1938 19H. D. Hatfield Scout