

KANSAS

IMPORTANT  
Kans. Geo. Survey request  
samples on this well.

WELL COMPLETION REPORT AND  
DRILLER'S LOG

S. 1 T. 16 R. 21 W

Loc. NW SW NW

County Sumner Ness

API No. 15 — 135 — 21,948  
County Number

Operator  
K. C. Oil Exploration, Inc.

Address 8600 W. 63rd St., Suite 307 Shawnee Mission, Ks. 66202


Well No. #1 Lease Name Sarvis

Footage Location  
feet from (N) (S) line feet from (E) (W) line

Principal Contractor THUNDERBIRD DRILLING Geologist MARK THOMPSON

Spud Date 1/20/81 Date Completed 1/28/81 Total Depth 4252 P.B.T.D.

Directional Deviation None Oil and/or Gas Purchaser

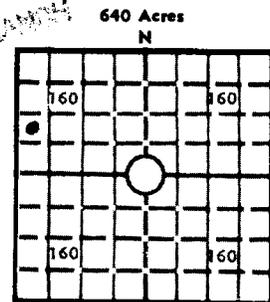

Elev.: Gr. 2259  
DF \_\_\_\_\_ KB 2264

CASING RECORD

Report of all strings set — surface, intermediate, production, etc.

Purpose of string	Size hole drilled	Size casing set (in O.D.)	Weight lbs/ft.	Setting depth	Type cement	Sacks	Type and percent additives
<u>SURFACE</u>	<u>12 7/8"</u>	<u>8 5/8"</u>	<u>28#</u>	<u>342'</u>	<u>REG</u>	<u>276</u>	<u>776# CAL.C.L.</u> <u>516# GEL</u>

LINER RECORD

PERFORATION RECORD

Top, ft.	Bottom, ft.	Sacks cement	Shots per ft.	Size & type	Depth interval

TUBING RECORD

Size	Setting depth	Packer set at

ACID, FRACTURE, SHOT, CEMENT SQUEEZE RECORD

Amount and kind of material used	Depth interval treated

INITIAL PRODUCTION

Date of first production		Producing method (flowing, pumping, gas lift, etc.)			
RATE OF PRODUCTION PER 24 HOURS	Oil	Gas	Water	Gas-oil ratio	
	bbis.	MCF	bbis.	CFPB	
Disposition of gas (vented, used on lease or sold)			Producing interval(s)		

INSTRUCTIONS: As provided in KCC Rule 82-2-125, within 90 days after completion of a well, one completed copy of this Drillers Log shall be transmitted to the State Geological Survey of Kansas, 4150 Monroe Street, Wichita, Kansas 67209. Copies of this form are available from the Conservation Division, State Corporation Commission, 245 No. Water, Wichita, Kansas 67202. Phone AC 316-522-2206. If confidential custody is desired, please note Rule 82-2-125. Drillers Logs will be on open file in the Oil and Gas Division, State Geological Survey of Kansas, Lawrence, Kansas 66044.

Operator

K.C. OIL EXPLORATIONS INC.

DESIGNATE TYPE OF COMP.: OIL, GAS, DRY HOLE, SWDW, ETC.:

Well No.

#1

Lease Name

SARVIS B

Dry Hole

S 1 T 16 S R 12 E (W)

WELL LOG

Show all important zones of porosity and contents thereof; cored intervals, and all drill-stem tests, including depth interval tested, cushion used, time tool open, flowing and shut-in pressures, and recoveries.

SHOW GEOLOGICAL MARKERS, LOGS RUN, OR OTHER DESCRIPTIVE INFORMATION.

FORMATION DESCRIPTION, CONTENTS, ETC.	TOP	BOTTOM	NAME	DEPTH

USE ADDITIONAL SHEETS, IF NECESSARY, TO COMPLETE WELL RECORD.

Date Received

*Arthur G. ...*  
Signature  
*President*  
Title

2-12-81

Date