

KANSAS


FORM 51 5M 1-42 PETROL

Barton

Section 10 Township 17 Range 11-W

Well No. #2 Stueder

Company Carter Oil

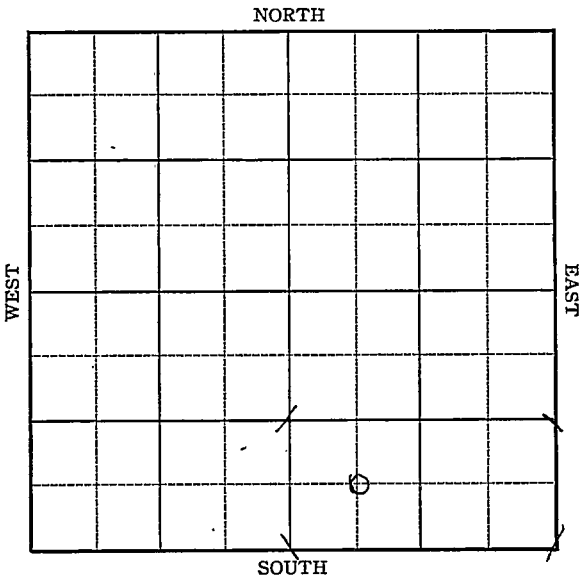

KANSAS

Barton

Sec. 10 Twp. 17 R. 11-W

Well No. #2 Stueder Farm

Carter Oil

Company


Kraft Prusa

_____ Ft. from N. Line

660 _____ Ft. from S. Line

_____ Ft. from E. Line

660 _____ Ft. from W. Line

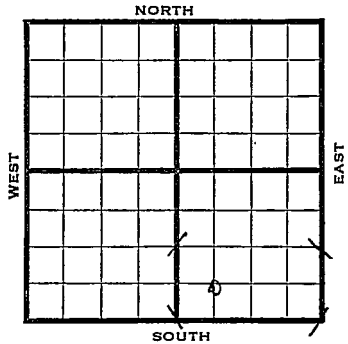

1943

REPORT

- 1/27 Rotary.
- 2/3 8" @ 292' WOC
- 2/10 Lans 3032
Drlg. 3077'
- 2/17 Congl. 3284
Arb 3318
SO 3318-20
TD 3320-25
5" Casing set 3318 RUST.
- 2/24 2850' Fluid in 2450'.
Arb. 3318
- 3/3 5" @ 3318'
T.D. 3325'
Pump 903 bbls oil plus 682 water Pot.
Gravity 43.2

COMPLETED

KANSAS

Map No. 55 Sec. 10 Twp. 17 R. 11W

Well No. 2 Stueder

Carter Oil Company,

FIRST REPORT Contractor

C SW SE

SECTION PLAT

_____ Ft. from N. Line

660 Ft. from S. Line

_____ Ft. from E. Line

660 Ft. from W. Line

		o	

KRAFT PRUSA POOL

Location _____

Rig up _____

Drilling and Remarks:

Rotary

RECORD

Cased _____ in., _____ ft.

Sand _____

Gas _____

Oil _____

Total Depth _____

PRODUCTION

1st 24 hrs. Nat. _____

1st 24 hrs. after shot _____

Gas _____ Cu. Ft.

Dry Hole _____

Abandoned _____

Date

JAN 27 1943 19

S. J. LEWIS Scout

KANSAS Barton

Map No. 55 Sec. 10 Twp. 17 R. 11WWell No. 2 StuederCarter Oil

Company

COMPLETED

Contractor

C SW SE

 Ft. from N. Line660 Ft. from S. Line Ft. from E. Line660 Ft. from W. Line

SECTION PLAT

		o	

KRAFT PRUSA POOLLocation Rig up

Drilling and Remarks:

Cor 833185" C3318.Pump 903 oil +
682 Water Pst.H32 Gr

RECORD

Cased in., ft.Sand Gas Oil Total Depth 3325

PRODUCTION

1st 24 hrs. Nat. 1st 24 hrs. after shot Gas Cu. Ft.Dry Hole Abandoned

Date

MAR 3 1943 19S. J. LEWIS Scout