


KANSAS

FORM 51 5M 4-41 PETROL **Barton**

Section 10 Township 17 Range 11W

Well No. 3 Kroutwurst

Company Carter Oil

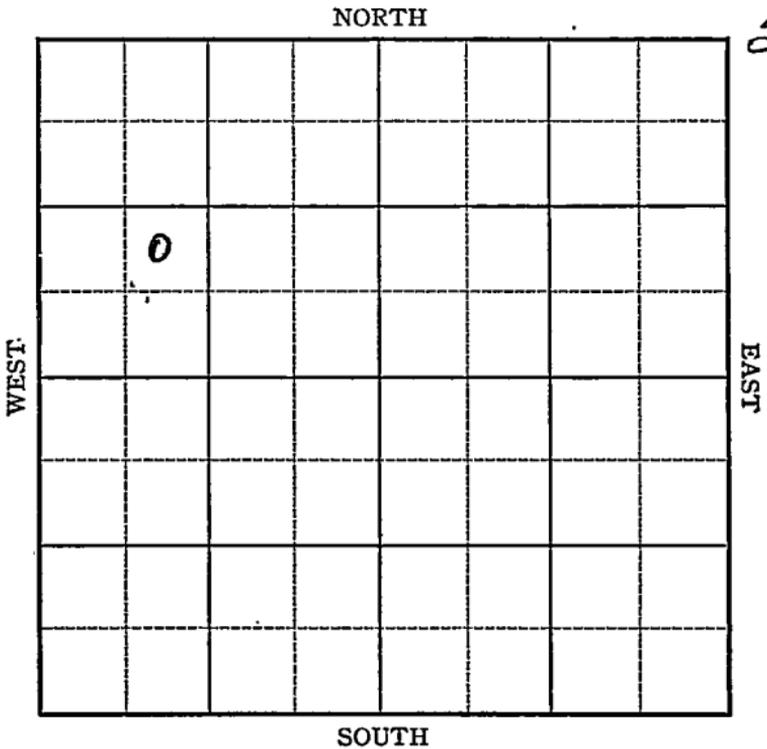

Sec. 10 Twp. 17 R. 11-W

Well No. #3 Kroutwurst Farm

Carter Oil Company

(Kraft)


_____ Ft. from N. Line

990 Ft. from S. Line

_____ Ft. from E. Line

990 Ft. from W. Line

Elev. 1868

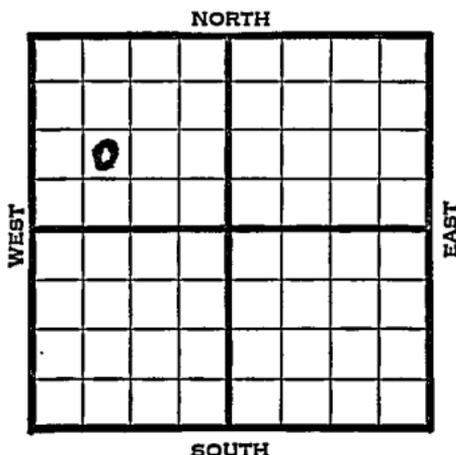

| 1941 | REPORT |
|------|--|
| 6/4 | Rotary. |
| 6/12 | 8" - 227' Drlg. 2605' |
| 6/19 | Lans. 3023' Arb. 2507 ³³⁰⁵ -11' T.D. 5" - 3306 ³³⁰⁶ ' RUST. |
| 6/26 | Arb. 3305' (Corrected) 5" - 3306' T.D. 3372' 1000 acid. |
| 7/3 | P.B. to 3346' 900' oil 400' wtr |
| 7/10 | P.B. to 3273' Ripped 5" casing 3210 to 3213' & 3115-18' H.F.W. Shut down. |
| 7/17 | " " |
| 7/24 | " " |
| 7/30 | Arb 3305' TD 3372' 5" @ 3306' Water |
| | ABANDONED |

Map No. _____ Sec. 10 Twp. 17 R. 11WWell No. 3 KroutwurstCarter Oil

Company

Contractor

FIRST REPORT

NE SW NW

_____ Ft. from N. Line

990 Ft. from S. Line

_____ Ft. from E. Line

990 Ft. from W. Line

KRAFT POOL

SECTION PLAT

| | | | |
|---|--|--|--|
| | | | |
| o | | | |
| | | | |
| | | | |

Location _____

Rig up _____

Drilling and Remarks:

Rotary

RECORD

Cased _____ in., _____ ft.

Sand _____

Gas _____

Oil _____

Total Depth _____

PRODUCTION

1st 24 hrs. Nat. _____

1st 24 hrs. after shot _____

Gas _____ Cu. Ft.

Dry Hole _____

Abandoned _____

Date

JUN 4 1941S. J. LEWIS Scout

KANSAS

Map No. _____ Sec. 10 Twp. 17 R. 11W

Well No. 3 Kroutwurst

Carter Oil Company

ABANDONED Contractor

SECTION PLAT

NE SW NW

_____ Ft. from N. Line

990 Ft. from S. Line

_____ Ft. from E. Line

990 Ft. from W. Line

| | | | |
|---|--|--|--|
| | | | |
| 0 | | | |
| | | | |
| | | | |

KRAFT POOL

RECORD

Location _____

Cased _____ in., _____ ft.

Rig up _____

Sand _____

Drilling and Remarks:

Gas _____

Oil _____

Total Depth 3372

Per 3805

5-10-3806

Water

PRODUCTION

1st 24 hrs. Nat. _____

1st 24 hrs. after shot _____

Gas _____ Cu. Ft.

Dry Hole _____

Abandoned _____

Date

JUL 30 1941 19

S. J. LEWIS Scout