


Section 10 Township 17 Range 11 W

Well No. # 3 Reiman

Company D. R. Lauck

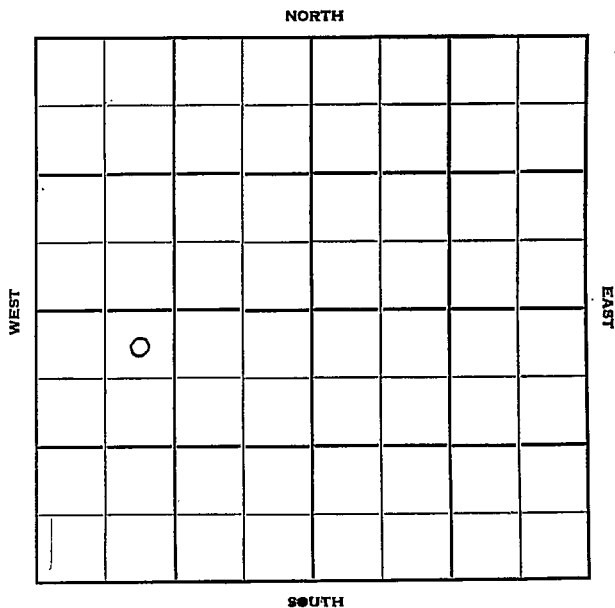

Barton

KANSAS

Sec. 10 Twp. 17 R. 11W

Well No. #3 Reiman Farm

D. R. Lauck Company

Contractor

Kraft Prusa Pool


330' Ft. from N. Line

_____ Ft. from S. Line

_____ Ft. from E. Line

990' Ft. from W. Line

NE NW SW

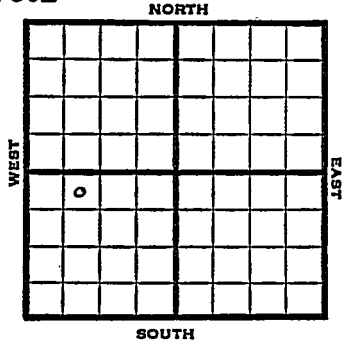

1951

Elev. 1856' REPORT

4/18

Location

5/2

Spud 4-20-51
 D & A TD 3328'
 10" @ 200 Anhy 670' Br.lime 3011'
 Lans. 3030' Cong 3295'
 TD 3328' D & A

ABANDONED

